

Registration Statement

OF CLAIMANT OF RIGHT TO APPROPRIATE GROUND WATER

TO THE STATE ENGINEER OF OREGON:

I, Clarence and Helen A. MacLean
of Route 1, Box 135, Jefferson County of Linn
(Mailing address)

State of Oregon do hereby make application for a certificate of registration as evidence of a right to appropriate ground water.

1. Source from which water is withdrawn is Pump well
(Flowing well, pump well, infiltration trench, or tunnel)

2. Location is: 9 miles North of Albany, Oregon
(Approximate distance and direction from nearest city or town)

and is more particularly described as follows:

(a) S. 1° 40' E. 19.2 Chains from NW corner of S. 4 of S. 3, T. 10S., R. 2W.
(Give distance and bearing to corner of section or other legal subdivision)

being within NW 1/4 of S. 4 of Sec. 3, Twp. 10 S., Rge. 2 W.
(Smallest legal subdivision) (N. or S.) (E. or W.)

or (b) within limits of recorded platted property, town or city:

in Lot _____ Block _____ of _____
(Name of plat or addition)

County of Linn
(If within city or town, give name)

3. Construction Work was begun on 1950; was completed on 1950
(Date) (Date)

and the ground water claimed was first used for the purposes set out below on 1950
(Date)

since which time the water has been used Continuously
(Continuously or Intermittently)

from 1950 to Present time
(Date) (Date)

4. Quantity of water claimed and used is 150 gallons per minute; 60.0 acre feet per year.

5. Purpose or Purposes for which water is used Irrigation
(Domestic, irrigation, municipal, manufacturing, industrial, etc.)

6. Description of Well: Depth 25 feet. Type drilled
(Dug or drilled)

diameter 8 inches. Elevation of ground at well site 205 feet, mean sea level
(As near as known)

Depth to water table 12 feet.

7. Capacity of Well: _____ g.p.m. with _____ feet drawdown.

_____ g.p.m. with _____ feet drawdown.

Date of test Not tested

If Flowing Well: Measured discharge _____ g.p.m. on _____
(Date)

Shut-in pressure at ground surface _____ lbs. per sq. in. on _____
(Date)

Water is controlled by _____
(Cap, valve, etc.)

If log of well is not available, give name and address of driller. Bill Hamilton Drilling Co.,
838 E. Third Ave., Albany, Oregon

11. Infiltration Trench: Covered or open

Dimensions: Length ft. Minimum depth ft. Maximum depth ft.
 Bottom width ft. Discharge g.p.m. Date of test

12. Tunnel: Type of lining

Dimensions:
(Length, course, and cross sectional size)
 Position of water bearing stratum with reference to portal of tunnel

Log of tunnel: (Preceding table for log of well may be used, if desired. Give footage from portal and character of materials, as pertinent.)

13. Pumping Equipment:

(a) Pump 1 1/2" centrifugal Capacity 150 g.p.m.
(Make, type and size)
 (b) Motor 5 H. P. electric
(Type and horsepower)

14. Location of area irrigated or to be irrigated, or place of use if for purposes other than irrigation.


Township North or South	Range E. or W. of Willamette Meridian	Section	Forty-acre Tract,	Number Acres To Be Irrigated	Date of Reclamation
10 S	3 W	3	NW 1/4 of SW 1/4	12.0	1950
10 S	3 W	3	SW 1/4 of SW 1/4	8.0	"
				20.0	

203-625 MacLean

Beginning at a point which is 20.17 chains North of the Southwest corner of Section 3, T. 10 S. R. 3 W. of the Will. mer. in Linn County, Oregon; and running thence East 20 chains, more or less, to the East line of lands formerly owned by William H. Rhodes; thence South 10 chains, more or less, to the northeast corner of lands conveyed by Ezer H. Rhodes, to W. W. Allen and V. D. Looney as recorded in Deed, Vol. 110, page 107; thence west along the north line of land afore described in said Vol. 110, page 107, 20 chains, more or less, to the west boundary line of said section 3; thence north on the west line of said section, 10 chains to the place of beginning, containing 20 acres, more or less, all lying and being in Linn County, Oregon.

15. If the ground water supply is supplemental to an existing water supply, identification of any application for a permit, permit, certificate or adjudicated right to appropriate water made or held by the registrant.

Township 10 S Range 3 W W.M.
North

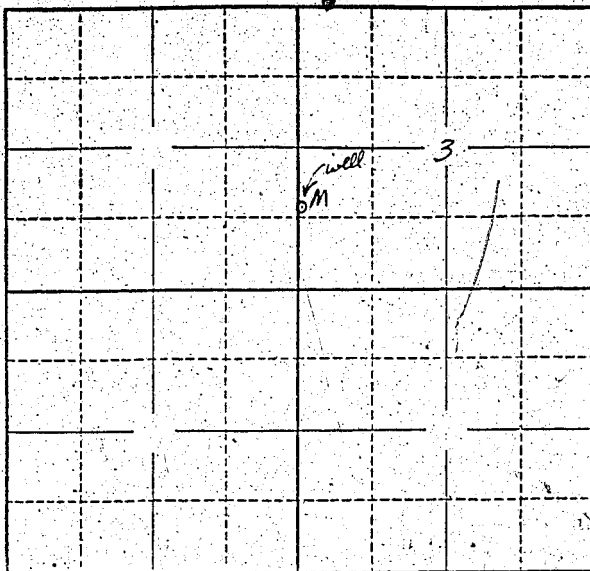

Locate well and acreage of irrigated land on plat.
Scale: 2" = 1 Mile

STATE OF OREGON }
County of LINN } ss.

I, Clarence and Helen A. MacLean, being first duly sworn, do hereby certify that I have read the foregoing Registration Statement and that all of the items therein contained are true to the best of my knowledge and belief.

Clarence MacLean
Helen A. MacLean
(Signature of Registrant)

Subscribed and sworn to before me this 19 day of July, 1958.

My commission expires 1959 NOTARY PUBLIC FOR OREGON

John B. [Signature]
(Notary Public)

(SEAL)

CERTIFICATE OF REGISTRATION

STATE OF OREGON }
County of Marion } ss.

This is to certify that the foregoing Registration Statement was received in the office of the State Engineer on the 16th day of July, 1958, at 8:00 o'clock A. M. and has been duly recorded in said office in Book No. 9 of Registration Statements on page GR-2102

Witness my hand this 16th day of February, 1959.

Leura A. Stanley
(State Engineer)

\$1500

By _____ (Deputy)