

Registration Statement

OF CLAIMANT OF RIGHT TO APPROPRIATE GROUND WATER

TO THE STATE ENGINEER OF OREGON:

I, J. V. Chandler

of P. O. Box 6344, Tigard, Oregon County of Washington
(Mailing address)

State of Oregon, do hereby make application for a certificate of registration as evidence of a right to appropriate ground water.

- 1. Source from which water is withdrawn is Pump well
(Flowing well, pump well, infiltration trench, or tunnel)
- 2. Location is: 1.7 miles south of Tigard, Oregon
(Approximate distance and direction from nearest city or town)

and is more particularly described as follows:

(a) 1700 feet south & 20.50 east from NE corner Section 10
(Give distance and bearing to corner of section or other legal subdivision)

being within SW 1/4 of NE 1/4 of Sec. 10, Twp. 2 South, Rge. 1 East
(Smallest legal subdivision) (N. or S.) (E. or W.)

or (b) within limits of recorded platted property, town or city:

in Lot _____, Block _____ of _____
(Name of plat or addition)
County of Washington
(If within city or town, give name)

3. Construction Work was begun on 3-1-48; was completed on 4-27-48
(Date) (Date)

and the ground water claimed was first used for the purposes set out below on 1-28-48
(Date)

since which time the water has been used intermittently during day
(Continuously or intermittently)
from 1948 to Oct. 1957
(Date) (Date)

4. Quantity of water claimed and used is 35 gallons per minute; _____ acre feet per year.

5. Purpose or Purposes for which water is used Industrial + Irrigation

(Domestic, irrigation, municipal, manufacturing, industrial, etc.)

6. Description of Well: Depth 183 feet. Type drilled
(Dug or drilled)

diameter 6 inches. Elevation of ground at well site _____ feet, mean sea level.
(As near as known)

Depth to water table 90 feet.

7. Capacity of Well: 35 g.p.m. with 55 feet drawdown.
_____ g.p.m. with _____ feet drawdown.


Date of test 4-28-48

If Flowing Well: Measured discharge _____ g.p.m. on _____
(Date)

Shut-in pressure at ground surface _____ lbs. per sq. in. on _____
(Date)

Water is controlled by _____
(Cap, valve, etc.)

Township 2 south Range 1 West, W.M.
North

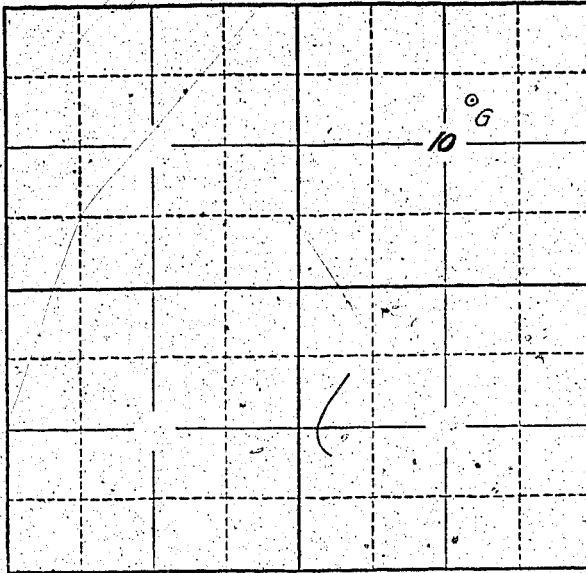

Locate well and acreage of irrigated land on plat.
Scale: 2" = 1 Mile

STATE OF OREGON

County of Marion } ss.

I, J. V. Chandler, being first duly sworn, do hereby certify that I have read the foregoing Registration Statement and that all of the items therein contained are true to the best of my knowledge and belief.

J. V. Chandler
(Signature of Registrant)

Subscribed and sworn to before me this 16th day of July, 19 58

My commission expires 12th June 1961 Wm. S. Bartholomew
(Notary Public)

(SEAL)

CERTIFICATE OF REGISTRATION

STATE OF OREGON } ss.
County of Marion

This is to certify that the foregoing Registration Statement was received in the office of the State Engineer on the 16th day of July, 19 58, at 10:45 o'clock A. M. and has been duly recorded in said office in Book No. 9 of Registration Statements on page GR 2104

Witness my hand this 16th day of February, 19 59
Laura A. Stanley
(State Engineer)

\$ 25.00

By _____
(Deputy)