

Registration Statement

OF CLAIMANT OF RIGHT TO APPROPRIATE GROUND WATER

TO THE STATE ENGINEER OF OREGON:

I, E. J. Diehl

of 1727 Thomas Road, Medford

(Mailing address)

County of Jackson

State of Oregon

do hereby make application for a certificate of registration as evidence of a right to appropriate ground water.

1. Source from which water is withdrawn is Infiltration trench (Sump)
(Flowing well, pump well, infiltration trench, or tunnel)

2. Location is: 3 miles South West of Medford
(Approximate distance and direction from nearest city or town)

and is more particularly described as follows:

(a) 1245 feet North and 1445 feet East from S. E. Cor. DIC #11
(Give distance and bearing to corner of section or other legal subdivision)

being within SW 1/4 SE 1/4 of Sec. 35, Twp. 37 S., Rge. 2 W.
(Smallest legal subdivision) (N. or S.) (E. or W.)

or (b) within limits of recorded platted property, town or city:

in Lot _____, Block _____ of _____
(Name of plat or addition)

County of _____
(If within city or town, give name)

3. Construction Work was begun on 1929 (neighbor's statement); was completed on Nov. 1, 1954
(Date) (Date)

and the ground water claimed was first used for the purposes set out below on about 1930 (neighbor's est.)
(Date)

since which time the water has been used Intermittently
(Continuously or Intermittently)

from 1930 to present date
(Date) (Date)

4. Quantity of water claimed and used is 25 gallons per minute; 8 acre feet per year.

5. Purpose or Purposes for which water is used irrigation

(Domestic, irrigation, municipal, manufacturing, industrial, etc.)

6. Description of Well: Depth 8 feet. Type Dug
(Dug or drilled)

diameter 50x50 inches. Elevation of ground at well site 1400 feet, mean sea level.
(As near as known)

Depth to water table 4.0 feet.

7. Capacity of Well: _____ g.p.m. with _____ feet drawdown.

_____ g.p.m. with _____ feet drawdown.

Date of test _____

If Flowing Well: Measured discharge _____ g.p.m. on _____
(Date)

Shut-in pressure at ground surface _____ lbs. per sq. in. on _____
(Date)

Water is controlled by _____
(Cap, valve, etc.)

8. Casing: (Give diameter, commercial specifications and depth below ground surface of each casing size.)

..... inch diameter none from to feet
 inch diameter from to feet
 inch diameter from to feet
 inch diameter from to feet

Describe and show depth of shoe, plug, adapter, liner or other details:

.....

9. Perforated Casings or Screens:

..... from to
 (Number per foot and size of perforations, or describe screen)
 from to
 from to
 from to

10. Log of Well: (Describe each stratum or formation clearly, indicate if water bearing, and give thickness and depth as indicated.)

MATERIAL	Thickness (Feet)	Depth to Bottom (Feet)
not known		

If log of well is not available, give name and address of driller.....

11. Infiltration Trench: Covered or open covered ~~sump~~ open.

Dimensions: Length 150 ft. Minimum depth 2 ft. Maximum depth 5 ft.

Bottom width 8" tile. ~~x~~ Discharge 25 g.p.m. Date of test July 1, 1958

12. Tunnel: Type of lining

Dimensions:
(Length, course, and cross sectional size)

Position of water bearing stratum with reference to portal of tunnel

Log of tunnel: (Preceding table for log of well may be used, if desired. Give footage from portal and character of materials, as pertinent.)

13. Pumping Equipment:

(a) Pump Berkley 1 1/8" Centrifugal Capacity 25 g.p.m.
(Make, type and size)

(b) Motor Electric 1/2 horsepower
(Type and horsepower)


14. Location of area irrigated or to be irrigated, or place of use if for purposes other than irrigation.

Township North or South	Range E. or W. of Willamette Meridian	Section	Forty-acre Tract	Number Acres To Be Irrigated	Date of Reclamation
37 S.	2 W.	35	SW 1/4 SE 1/4	1.8 acres	1930

15. If the ground water supply is supplemental to an existing water supply, identification of any application for a permit, permit, certificate or adjudicated right to appropriate water made or held by the registrant.
none

Township 37 S Range 2 W W.M.

North

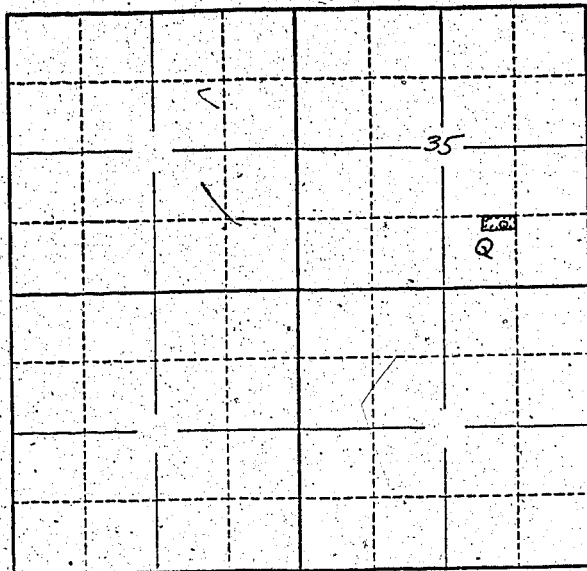

Locate well and acreage of irrigated land on plat.

Scale: 2" = 1 Mile

STATE OF OREGON

County of Jackson

ss.

I, E. J. Diehl, being first duly sworn, do hereby certify that I have read the foregoing Registration Statement and that all of the items therein contained are true to the best of my knowledge and belief.

E. J. Diehl
(Signature of Registrant)

Subscribed and sworn to before me this 14th day of July, 1958

My commission expires July 15, 1961

Lawrence L. Smith
(Notary Public)

(SEAL)

CERTIFICATE OF REGISTRATION

STATE OF OREGON

County of Marion

ss.

This is to certify that the foregoing Registration Statement was received in the office of the State Engineer on the 16th day of July, 1958, at 8:00 o'clock A. M. and has been duly recorded in said office in Book No. 9 of Registration Statements on page GR 2107

Witness my hand this 10th day of March, 1959

Lawrence L. Stanley
(State Engineer)

By _____ (Deputy)

GR - 2107

#1500