

# Registration Statement

## OF CLAIMANT OF RIGHT TO APPROPRIATE GROUND WATER

TO THE STATE ENGINEER OF OREGON:

I, Henry F. Hebard

of Rte. 2, Box 965, Roseburg

County of Douglas

State of Oregon

, do hereby make application for a certificate of registration as evidence of a right to appropriate ground water.

1. Source from which water is withdrawn is pump well  
(Flowing well, pump well, infiltration trench, or tunnel)

2. Location is: 11 miles NW from Roseburg  
(Approximate distance and direction from nearest city or town)

and is more particularly described as follows:

(a) 350 ft N and 98 ft W from SE cor. Lot 10 B17  
(Give distance and bearing to corner of section or other legal subdivision)

being within NW 1/4 SW 1/4 of Sec. 19, Twp. 26 S, Rge. 6 W  
(Smallest legal subdivision) (N. or S.) (E. or W.)

or (b) within limits of recorded platted property, town or city:

in Lot 10, Block 7 of Plot A Roseburg Home Orchard Tract  
(Name of plat or addition)

County of Douglas  
(If within city or town, give name)

3. Construction Work was begun on June 1950, was completed on Sept. 1950  
(Date) (Date)

and the ground water claimed was first used for the purposes set out below on 1950  
(Date)

since which time the water has been used during each irrigation season  
(Continuously or intermittently)

from 1950 to July 15 1958  
(Date) (Date)

4. Quantity of water claimed and used is 60 gallons per minute; 1 acre feet per year.

5. Purpose or Purposes for which water is used irrigation

(Domestic, irrigation, municipal, manufacturing, industrial, etc.)

6. Description of Well: Depth 50 ft feet. Type drilled  
(Dug or drilled)

diameter 6 inches. Elevation of ground at well site 385 feet, mean sea level.  
(As near as known)

Depth to water table 15 feet.

7. Capacity of Well: \_\_\_\_\_ g.p.m. with \_\_\_\_\_ feet drawdown.

\_\_\_\_\_ g.p.m. with \_\_\_\_\_ feet drawdown.

Date of test Not tested

If Flowing Well: Measured discharge \_\_\_\_\_ g.p.m. on \_\_\_\_\_  
(Date)

Shut-in pressure at ground surface \_\_\_\_\_ lbs. per sq. in. on \_\_\_\_\_  
(Date)

Water is controlled by \_\_\_\_\_  
(Cap, valve, etc.)

8. Casing: (Give diameter, commercial specifications and depth below ground surface of each casing size.)

6 inch diameter ..... from top to 20 feet  
 ..... inch diameter ..... from ..... to ..... feet  
 ..... inch diameter ..... from ..... to ..... feet  
 ..... inch diameter ..... from ..... to ..... feet

Describe and show depth of shoe, plug, adapter, liner or other details: .....

9. Perforated Casings or Screens:

..... from ..... to .....  
 (Number per foot and size of perforations, or describe screen)  
 ..... from ..... to .....  
 ..... from ..... to .....  
 ..... from ..... to .....


10. Log of Well: (Describe each stratum or formation clearly, indicate if water bearing, and give thickness and depth as indicated.)

MATERIAL	Thickness (Feet)	Depth to Bottom (Feet)
River bottom loam	15	50
Gravel	15	55
Rock	20	20



Township 265 Range 6 W, W.M.

North

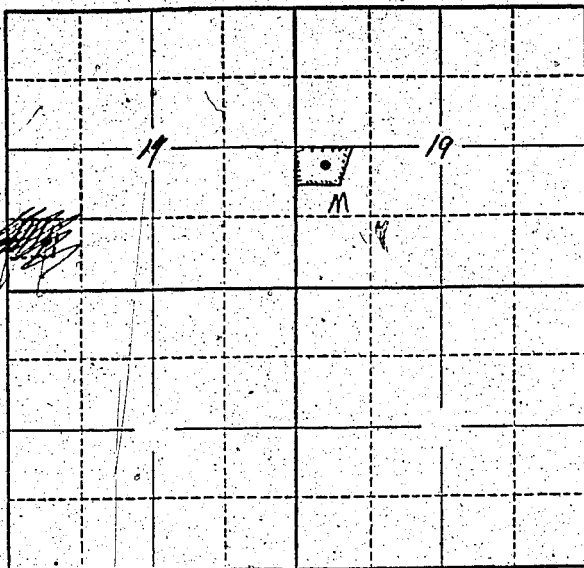

Locate well and acreage of irrigated land on plat.

Scale: 2" = 1 Mile

STATE OF OREGON

County of Douglas

} ss.

I, Henry F. Hubbard, being first duly sworn, do hereby certify that I have read the foregoing Registration Statement and that all of the items therein contained are true to the best of my knowledge and belief.

Henry F. Hubbard  
(Signature of Registrant)

Subscribed and sworn to before me this 14 day of July, 1958

My commission expires \_\_\_\_\_

Char. Deerns  
(Notary Public)

(SEAL)

County Clerk

### CERTIFICATE OF REGISTRATION

STATE OF OREGON

County of Marion

} ss.

This is to certify that the foregoing Registration Statement was received in the office of the State Engineer on the 16<sup>th</sup> day of July, 1958, at 8:00 o'clock A.M. and has been duly recorded in said office in Book No. 9 of Registration Statements on page GR-2108

Witness my hand this 10<sup>th</sup> day of March, 1959

Lewis A. Stanley  
(State Engineer)

By \_\_\_\_\_

(Deputy)

GR - 2108

#1500