

Registration Statement

OF CLAIMANT OF RIGHT TO APPROPRIATE GROUND WATER

TO THE STATE ENGINEER OF OREGON:

I, Hugo W. and Olivia H. Ehrlich

of Route 3, Box 1058 Albany County of Linn
(Mailing address)

State of Oregon, do hereby make application for a certificate of registration as evidence of a right to appropriate ground water.

1. Source from which water is withdrawn is pump well
(Flowing well, pump well, infiltration trench, or tunnel)

2. Location is: 5 miles South East of Albany, Oregon
(Approximate distance and direction from nearest city or town)

and is more particularly described as follows:

(a) S. 33^{90'} 30' N. 9.5 Chains from NE corner of N. 32, T. 11S, R. 3W.
(Give distance and bearing to corner of section or other legal subdivision)

being within NE^{1/4} of MW^{1/4} of Sec. 32, Twp. 11S., Rge. 3W.
(Smallest legal subdivision) (N. or S.) (E. or W.)

or (b) within limits of recorded platted property, town or city:

in Lot _____, Block _____ of _____
(Name of plat or addition)

(if within city or town, give name) County of Linn

3. Construction Work was begun on October 1, 1952, was completed on October 16, 1952
(Date) (Date)

and the ground water claimed was first used for the purposes set out below on May 15, 1953
(Date)

since which time the water has been used Intermittently
(Continuously or Intermittently)

from May 1953 to present time
(Date) (Date)

4. Quantity of water claimed and used is 17 gallons per minute; _____ acre feet per year.

5. Purpose or Purposes for which water is used Irrigation
(Domestic, irrigation, municipal, manufacturing, industrial, etc.)

6. Description of Well: Depth _____ feet. Type drilled
(Dug or drilled)

diameter _____ inches. Elevation of ground at well site 243 feet, mean sea level.
(As near as known)

Depth to water table 35 feet.

7. Capacity of Well: 300 g.p.m. with 57 feet drawdown.
_____ g.p.m. with _____ feet drawdown.

Date of test October 16, 1952

If Flowing Well: Measured discharge _____ g.p.m. on _____
(Date)

Shut-in pressure at ground surface _____ lbs. per sq. in. on _____
(Date)

Water is controlled by _____
(Cap, valve, etc.)

8. Casing: (Give diameter, commercial specifications and depth below ground surface of each casing size.)

10 inch diameter Steel casing from 0 to 102 feet
 inch diameter from to feet
 inch diameter from to feet
 inch diameter from to feet

Describe and show depth of shoe, plug, adapter, liner or other details:


9. Perforated Casings or Screens:

Slot perforations from 27 to 29
 (Number per foot and size of perforations, or describe screen)
 from 35 to 39
 from 55 to 59
 from 99 to 102

10. Log of Well: (Describe each stratum or formation clearly, indicate if water bearing, and give thickness and depth as indicated.)

MATERIAL	Thickness (Feet)	Depth to Bottom (Feet)
Clay	15	15
Hardpan	11	27
Clay	12	29
Gravel	7	36
Clay	5	41
Hardpan	9	50
Loose gravel	4	54
Gravel	11	65
Gravel and Clay	20	85
Brown Gravel and Sand	5	90
Gravel and Clay	14	104
Black Sand	4	108
Loose Gravel	14	122

Township 11S. Range 3 W., W.M.
North

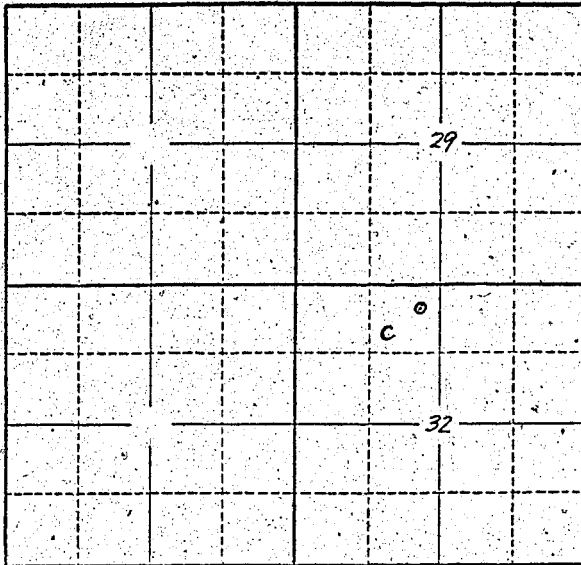

Locate well and acreage of irrigated land on plat.
Scale: 2" = 1 Mile

STATE OF OREGON

County of Linn } ss.

I, Hugo W. and Olivia H. Ehrlich, being first duly sworn, do hereby certify that I have read the foregoing Registration Statement and that all of the items therein contained are true to the best of my knowledge and belief.

Hugo W. Ehrlich Olivia H. Ehrlich
(Signature of Registrant)

Subscribed and sworn to before me this 14th day of July, 1958

My commission expires My Commission Expires July 2, 1959
NOTARY PUBLIC FOR OREGON
James L. Stinson
(Notary Public)

(SEAL)

CERTIFICATE OF REGISTRATION

STATE OF OREGON

County of Marion } ss.

This is to certify that the foregoing Registration Statement was received in the office of the State Engineer on the 16th day of July, 1958, at 8:00 o'clock A.M. and has been duly recorded in said office in Book No. 9 of Registration Statements on page GR-2113

Witness my hand this 10th day of March, 1959

Lewis A. Stanley
(State Engineer)

By _____
(Deputy)

GR-2113

#1500