

Registration Statement

OF CLAIMANT OF RIGHT TO APPROPRIATE GROUND WATER

TO THE STATE ENGINEER OF OREGON:

I, Pernal and Weyona Dodele

of 2540 Broadway, Albany County of Linn
(Mailing address)

State of Oregon, do hereby make application for a certificate of registration as evidence of a right to appropriate ground water.

1. Source from which water is withdrawn is Pump well
(Flowing well, pump well, infiltration trench, or tunnel)

2. Location is: 1/2 mile South of Albany, Oregon
(Approximate distance and direction from nearest city or town)

and is more particularly described as follows:

(a) 1254' S. and 1815' E. of NW corner S. 13, T. 11S., R. 4, W.
(Give distance and bearing to corner of section or other legal subdivision)
being within NE 1/4 of NW 1/4 of Sec. 13, Twp. 11S, Rge. 4W
(Smallest legal subdivision) (N. or S.) (E. or W.)

or (b) within limits of recorded platted property, town or city:

in Lot _____, Block _____ of _____
(Name of plat or addition)
County of Linn
(If within city or town, give name)

3. Construction Work was begun on December 1945; was completed on December 1945
(Date) (Date)

and the ground water claimed was first used for the purposes set out below on April 1946
(Date)

since which time the water has been used Continuously
(Continuously or Intermittently)

from April 1946 to present time
(Date) (Date)

4. Quantity of water claimed and used is 400 gallons per minute; 2.0 acre feet per year.

5. Purpose or Purposes for which water is used Domestic and irrigation

(Domestic, irrigation, municipal, manufacturing, industrial, etc.)

6. Description of Well: Depth 49 feet. Type drilled
(Dug or drilled)

diameter 4 inches. Elevation of ground at well site 200 feet, mean sea level.
(As near as known)

Depth to water table 18 feet.

7. Capacity of Well: _____ g.p.m. with _____ feet drawdown.

_____ g.p.m. with _____ feet drawdown.

Date of test Not tested

If Flowing Well: Measured discharge _____ g.p.m. on _____
(Date)

Shut-in pressure at ground surface _____ lbs. per sq. in. on _____
(Date)

Water is controlled by _____
(Cap, valve, etc.)

8. Casing: (Give diameter, commercial specifications and depth below ground surface of each casing size.)

4 inch diameter, steel casing from 0 to 21 feet
 _____ inch diameter _____ from _____ to _____ feet
 _____ inch diameter _____ from _____ to _____ feet
 _____ inch diameter _____ from _____ to _____ feet

Describe and show depth of shoe, plug, adapter, liner or other details: _____

9. Perforated Casings or Screens:

Slot perforations from 17 to 21
(Number per foot and size of perforations, or describe screen)
 _____ from _____ to _____
 _____ from _____ to _____
 _____ from _____ to _____

10. Log of Well: (Describe each stratum or formation clearly, indicate if water bearing, and give thickness and depth as indicated.)

MATERIAL	Thickness (Feet)	Depth to Bottom (Feet)
Not available		

If log of well is not available, give name and address of driller. Bill Slate Tangent, Oregon

11. Infiltration Trench: Covered or open

Dimensions: Length ft. Minimum depth ft. Maximum depth ft.

Bottom width ft. Discharge g.p.m. Date of test

12. Tunnel: Type of lining

Dimensions:
(Length, course, and cross sectional size)

Position of water bearing stratum with reference to portal of tunnel

Log of tunnel: (Preceding table for log of well may be used, if desired. Give footage from portal and character of materials, as pertinent.)

13. Pumping Equipment:

(a) Pump Advance, Deep Well 1" - 3/4" Capacity 600 g.p.m.
(Make, type and size)


(b) Motor 1/2 H.P. electric
(Type and horsepower)

14. Location of area irrigated or to be irrigated, or place of use if for purposes other than irrigation

Township North or South	Range E. or W. of Willamette Meridian	Section	Forty-acre Tract	Number Acres To Be Irrigated	Date of Reclamation
11 S.	4 W	13	NE 1/4 of NW 1/4	1.0	April 1946

15. If the ground water supply is supplemental to an existing water supply, identification of any application for a permit, permit, certificate or adjudicated right to appropriate water made or held by the registrant.

Township 11S Range 4 W, W.M.
North

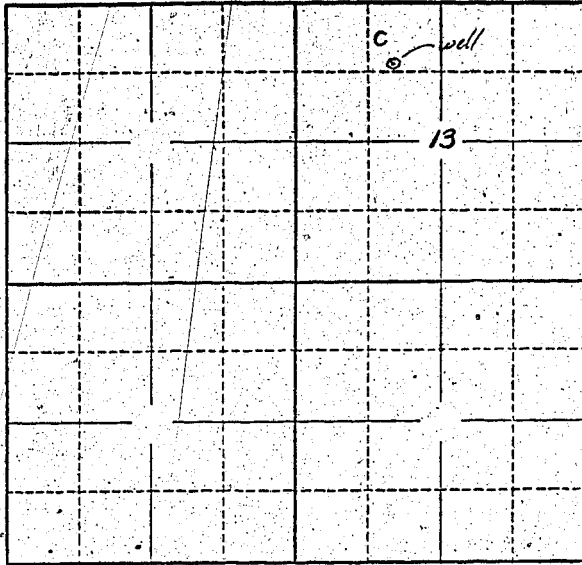

Locate well and acreage of irrigated land on plat.
Scale: 2" = 1 Mile

STATE OF OREGON

County of Linn } ss.

I, Pernal and Weyona Dodele, being first duly sworn, do hereby certify that I have read the foregoing Registration Statement and that all of the items therein contained are true to the best of my knowledge and belief.

Weyona Dodele
Pernal Dodele
(Signature of Registrant)

Subscribed and sworn to before me this 14 day of July, 1958

My commission expires My Commission expires May 24, 1959
R. P. Swanton
(Notary Public)

(SEAL)

CERTIFICATE OF REGISTRATION

STATE OF OREGON } ss.
County of Marion

This is to certify that the foregoing Registration Statement was received in the office of the State Engineer on the 16th day of July, 1958, at 8:00 o'clock A.M. and has been duly recorded in said office in Book No. 9 of Registration Statements on page GR-2114

Witness my hand this 10th day of March, 19 59

Laura A. Stanley
(State Engineer)

\$15.00

By _____ (Deputy)