

# Registration Statement

## OF CLAIMANT OF RIGHT TO APPROPRIATE GROUND WATER

(Under Chapter 708, Oregon Laws 1955.)

TO THE STATE ENGINEER OF OREGON;

I, Herman J. Kessler

of Corvallis Box 362 County of Benton

State of Oregon, do hereby make application for a certificate of registration as evidence of a right to appropriate ground water.

1. Source from which water is withdrawn is puer well  
(Flowing well, pump well, infiltration trench, or tunnel)

2. Location is: 2 1/2 miles northeast of Corvallis  
(Approximate distance and direction from nearest city or town)

and is more particularly described as follows:

(a) 1610 feet West & 350 feet South from NE Corner Section 25  
(Give distance and bearing to corner of section or other legal subdivision)

being within Sublot SE 4 of Sec. 29, Twp. 11S, Rge. 5W  
(Smallest legal subdivision) (S. or S.) (E. or W.)

or (b) within limits of recorded platted property, town or city: 435 feet North and 127 feet West of southeast corner

in Lot 13, Block \_\_\_\_\_ of Willamette Dale Farm  
(Name of plat or addition)

County of Benton  
(If within city or town, give name)

3. Construction Work was begun on 1942; was completed on same year  
(Date) (Date)

and the ground water claimed was first used for the purposes set out below on May 1st 1942  
(Date)

since which time the water has been used continuously  
(Continuously or Intermittently)

from May 1 to Oct 1st  
(Date) (Date)

4. Quantity of water claimed and used is 150 gallons per minute; 165 acre feet per year.

5. Purpose or Purposes for which water is used Irrigation

(Domestic, irrigation, municipal, manufacturing, industrial, etc.)

6. Description of Well: Depth 28 feet. Type Driven  
(Dug or drilled)

diameter 2 1/2 inches. Elevation of ground at well site 212 feet, mean sea level.  
(As near as known)

Depth to water table \_\_\_\_\_ feet.

7. Capacity of Well: 165 g.p.m. with 8 feet drawdown.

\_\_\_\_\_ g.p.m. with \_\_\_\_\_ feet drawdown.

Date of test May 15 1942

If Flowing Well: Measured discharge \_\_\_\_\_ g.p.m. on \_\_\_\_\_  
(Date)


Shut-in pressure at ground surface \_\_\_\_\_ lbs. per sq. in. on \_\_\_\_\_  
(Date)

Water is controlled by \_\_\_\_\_  
(Cap, valve, etc.)





Township 115 Range 54 W.M.  
North

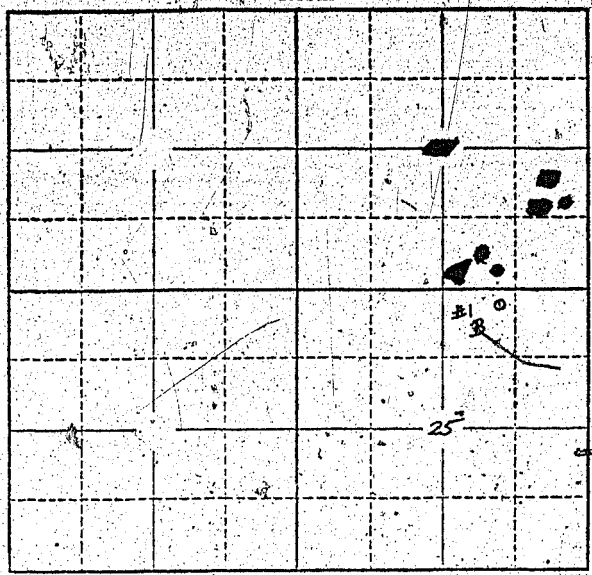

Locate well and acreage of irrigated land on plat.  
Scale: 2" = 1 Mile

STATE OF OREGON }  
County of Benton } ss.

I, Herman J. Kissler, being first duly sworn, do hereby certify that I have read the foregoing Registration Statement and that all of the items therein contained are true to the best of my knowledge and belief.

Herman J. Kissler  
(Signature of Registrant)

Subscribed and sworn to before me this 11th day of July, 1958

My commission expires Sept. 29, 1961  
Margaret B. Johnson  
(Notary Public)

(SEAL)

**CERTIFICATE OF REGISTRATION**

STATE OF OREGON }  
County of Marion } ss.

This is to certify that the foregoing Registration Statement was received in the office of the State Engineer on the 15th day of July, 1958, at 8:00 o'clock A.M. and has been duly recorded in said office in Book No. 9 of Registration Statements on page GR-2127

~~Construction shall be completed by \_\_\_\_\_ 19\_\_\_\_ and the water to be applied to beneficial uses by \_\_\_\_\_ 19\_\_\_\_~~

Witness my hand this 10th day of March, 1959

Henry A. Ottaway  
(State Engineer)

By \_\_\_\_\_  
(Deputy)

GR-2127

1500