

# Registration Statement

## OF CLAIMANT OF RIGHT TO APPROPRIATE GROUND WATER

TO THE STATE ENGINEER OF OREGON:

I, Walter H. Schuerch  
of Route 1 Willamina Oregon County of Polk  
(Mailing address)

State of Oregon, do hereby make application for a certificate of registration as evidence of a right to appropriate ground water.

- 1. Source from which water is withdrawn is Pump Well  
(Flowing well, pump well, infiltration trench, or tunnel)
- 2. Location is: Two miles west Willamina Ore.  
(Approximate distance and direction from nearest city or town)

and is more particularly described as follows:

(a) 1150' N. + 2200' N From SE Corner Sec. 14  
(Give distance and bearing to corner of section or other legal subdivision)  
being within N.E. 1/4 S.E. 1/4 of Sec. 14, Twp. 6 S. Rge. 7 W.  
(Smallest legal subdivision) (N. or S.) (E. or W.)

or (b) within limits of recorded platted property, town or city:

in Lot \_\_\_\_\_, Block \_\_\_\_\_ of \_\_\_\_\_  
(Name of plat or addition)

County of \_\_\_\_\_  
(If within city or town, give name)

3. Construction Work was begun on July 1, 1952; was completed on July 20, 1952  
(Date) (Date)  
and the ground water claimed was first used for the purposes set out below on Sept. 1, 1952  
(Date)

since which time the water has been used intermittently  
(Continuously or intermittently)  
from May to Oct.  
(Date) (Date)

4. Quantity of water claimed and used is 20 gallons per minute; \_\_\_\_\_ acre feet per year.

5. Purpose or Purposes for which water is used Irrigation

6. Description of Well: Depth 16 1/2 feet. Type Dug 14 FT Drilled 2 1/2 ft  
(Dug or drilled)  
diameter 4.8 + 1 1/2 in inches. Elevation of ground at well site 130 feet, mean sea level.  
(As near as known)  
Depth to water table 8 feet.

7. Capacity of Well: 6 g.p.m. with \_\_\_\_\_ feet drawdown to Bottom  
\_\_\_\_\_ g.p.m. with \_\_\_\_\_ feet drawdown.

Date of test \_\_\_\_\_

If Flowing Well: Measured discharge \_\_\_\_\_ g.p.m. on \_\_\_\_\_  
(Date)

Shut-in pressure at ground surface \_\_\_\_\_ lbs. per sq. in. on \_\_\_\_\_  
(Date)

Water is controlled by \_\_\_\_\_  
(Cap, valve, etc.)

8. Casing: (Give diameter, commercial specifications and depth below ground surface of each casing size.)

48 inch diameter *Concrete Tile* from 0 to 14 feet  
 inch diameter from to feet  
 inch diameter from to feet  
 inch diameter from to feet

Describe and show depth of shoe, plug, adapter, liner or other details:

9. Perforated Casings or Screens:

*none* from to  
(Number per foot and size of perforations, or describe screen)  
 from to  
 from to  
 from to

10. Log of Well: (Describe each stratum or formation clearly, indicate if water bearing, and give thickness and depth as indicated.)

MATERIAL	Thickness (Feet)	Depth to Bottom (Feet)
<i>Soil</i>	<i>6 ft</i>	
<i>Gravel</i>	<i>8 ft</i>	
<i>Bed rock</i>	<i>2 1/2 ft</i>	

If log of well is not available, give name and address of driller. ....

11. Infiltration Trench: Covered or open .....

Dimensions: Length ..... ft. Minimum depth ..... ft. Maximum depth ..... ft.

Bottom width ..... ft. Discharge ..... g.p.m. Date of test .....

12. Tunnel: Type of lining .....

Dimensions: .....  
(Length, course, and cross sectional size)

Position of water bearing stratum with reference to portal of tunnel .....

Log of tunnel: (Preceding table for log of well may be used, if desired. Give footage from portal and character of materials, as pertinent.)

13. Pumping Equipment:

(a) Pump Wards Jet ..... Capacity 10 g.p.m.  
(Make, type and size)


(b) Motor Electric 2 1/2 .....  
(Type and horsepower)

14. Location of area irrigated or to be irrigated, or place of use if for purposes other than irrigation.

Township North or South	Range E. or W. of Willamette Meridian	Section	Forty-acre Tract	Number Acres To Be Irrigated	Date of Reclamation
6S	7W	14	NE 1/4 S.E. 1/4	1.8	1952

15. If the ground water supply is supplemental to an existing water supply, identification of any application for a permit, permit, certificate or adjudicated right to appropriate water made or held by the registrant.  
None.

Township 6S Range 7W, W.M.  
North

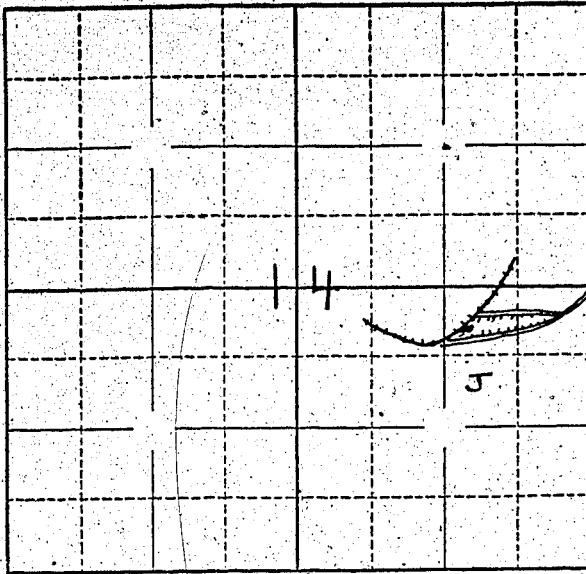

Locate well and acreage of irrigated land on plat.

Scale:  $\frac{1}{4}$ " = 1 Mile

STATE OF OREGON

County of Marion } ss.

I, Walter W. Schuerch, being first duly sworn, do hereby certify that I have read the foregoing Registration Statement and that all of the items therein contained are true to the best of my knowledge and belief.

Walter W. Schuerch  
(Signature of Registrant)

Subscribed and sworn to before me this 17th day of July, 1958

My commission expires 12th June 1961 Wm. S. Baitholomew  
(Notary Public)

(SEAL)

**CERTIFICATE OF REGISTRATION**

STATE OF OREGON } ss.  
County of Marion

This is to certify that the foregoing Registration Statement was received in the office of the State Engineer on the 17th day of July, 1958, at 10:15 o'clock A. M. and has been duly recorded in said office in Book No. 9 of Registration Statements on page GR-2132

Witness my hand this 10th day of March, 1959

Lewis A. Stanley  
(State Engineer)

By \_\_\_\_\_ (Deputy)

\$1500

GR-2132