

Registration No. GR. - 2229

Certificate No. GR. - 2135

Registration Statement

OF CLAIMANT OF RIGHT TO APPROPRIATE GROUND WATER

TO THE STATE ENGINEER OF OREGON:

I, R. M. Carpenter, President, Creswell Sand & Gravel Co., Inc.
of P. O. Box 104, Creswell, Oregon County of Lane
(Mailing address)

State of Oregon, do hereby make application for a certificate of registration as evidence of a right to appropriate ground water.

1. Source from which water is withdrawn is Pump well
(Flowing well, pump well, infiltration trench, or tunnel)
2. Location is: One mile East of Creswell
(Approximate distance and direction from nearest city or town)

and is more particularly described as follows:

(a) 250 feet North and 50 feet East of N.E. corner of Joseph Betty D.L.C. # 48
(Give distance and bearing to corner of section or other legal subdivision)
being within NW 1/4 of SE 1/4 of Sec. 13, Twp. 19 S, Rge. 3
(Smallest legal subdivision) (N. or S.) (E. or W.)

or (b) within limits of recorded platted property, town or city:

in Lot _____, Block _____ of _____
(Name of plat or addition)
County of Lane
(If within city or town, give name)

3. Construction Work was begun on July 1948; was completed on July 1948
(Date) (Date)

and the ground water claimed was first used for the purposes set out below on July 1948
(Date)

since which time the water has been used for washing sand and gravel continuously
(Continuously or Intermittently)

from January 1 to December 31
(Date) (Date)

4. Quantity of water claimed and used is 300 gallons per minute; _____ acre feet per year.

5. Purpose or Purposes for which water is used Industrial, for washing sand and gravel and use in ready mix concrete
(Domestic, irrigation, municipal, manufacturing, industrial, etc.)

6. Description of Well: Depth 15 feet. Type dug
(Dug or drilled)

diameter 40' x 100 inches. Elevation of ground at well site 420 feet, mean sea level.
(As near as known)

Depth to water table 10 feet.

7. Capacity of Well: _____ g.p.m. with _____ feet drawdown.
_____ g.p.m. with _____ feet drawdown.


Date of test _____

If Flowing Well: Measured discharge _____ g.p.m. on _____
(Date)

Shut-in pressure at ground surface _____ lbs. per sq. in. on _____
(Date)

Water is controlled by _____
(Cap, valve, etc.)

Township 19S Range 3W, W.M.
North

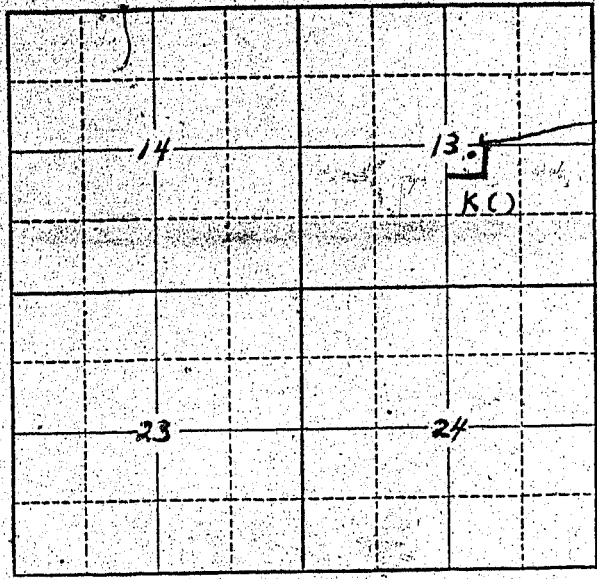

Locate well and acreage of irrigated land on plat.
Scale: 2" = 1 Mile

STATE OF OREGON
County of Lane } ss.

I, R. M. Carpenter, being first duly sworn, do hereby certify that I have read the foregoing Registration Statement and that all of the items therein contained are true to the best of my knowledge and belief.

R. M. Carpenter
(Signature of Registrant)

Subscribed and sworn to before me this 17th day of May, 1958.

My commission expires April 23, 1962

Donald W. Taylor
(Notary Public)

(SEAL)

CERTIFICATE OF REGISTRATION

STATE OF OREGON }
County of Marion } ss.

This is to certify that the foregoing Registration Statement was received in the office of the State Engineer on the 17th day of July, 1958, at 8:00 o'clock A. M. and has been duly recorded in said office in Book No. 9 of Registration Statements on page GR-2135

Witness my hand this 10th day of March, 1959

Laura A. Stanley
(State Engineer)

By _____
(Deputy)

\$ 20.00

GR - 2135