

RECEIVED
JUL 17 1958
STATE ENGINEER
SALEM, OREGON

Registration No. GR - 2231
Certificate No. GR - 3828

Registration Statement

OF CLAIMANT OF RIGHT TO APPROPRIATE GROUND WATER

TO THE STATE ENGINEER OF OREGON:

I, Gus & Anna Leder

of Scio, Ore County of LINN

State of Oregon do hereby make application for a certificate of registration as evidence of a right to appropriate ground water.

1. Source from which water is withdrawn is Well - Pump

2. Location is: City Limits of Scio, Oregon

and is more particularly described as follows:

(a) 1450' W + 175' North of SE corner S7, T10, R1W

being within SW 1/4 of SE 1/4 of Sec. 7 Twp. 10S Rge. 1W

or (b) within limits of recorded platted property, town or city:

in Lot _____, Block _____ of _____

County of _____

3. Construction Work was begun on Aug 3, 1954; was completed on Aug 5, 1954

and the ground water claimed was first used for the purposes set out below on Aug 1954

since which time the water has been used Irrigation

from 1954 to Nov 1958

4. Quantity of water claimed and used is 75 gallons per minute; _____ acre feet per year.

5. Purpose or Purposes for which water is used

Irrigation

6. Description of Well: Depth 20 feet. Type Drilled

diameter 8 inches. Elevation of ground at well site 376 feet, mean sea level.

Depth to water table 4 in well

7. Capacity of Well: 75 g.p.m. with 8 feet drawdown.

_____ g.p.m. with _____ feet drawdown.


Date of test This Summer

If Flowing Well: Measured discharge _____ g.p.m. on _____

Shut-in pressure at ground surface _____ lbs. per sq. in. on _____

Water is controlled by _____

Township 10 S Range 1 W, W.M.
North

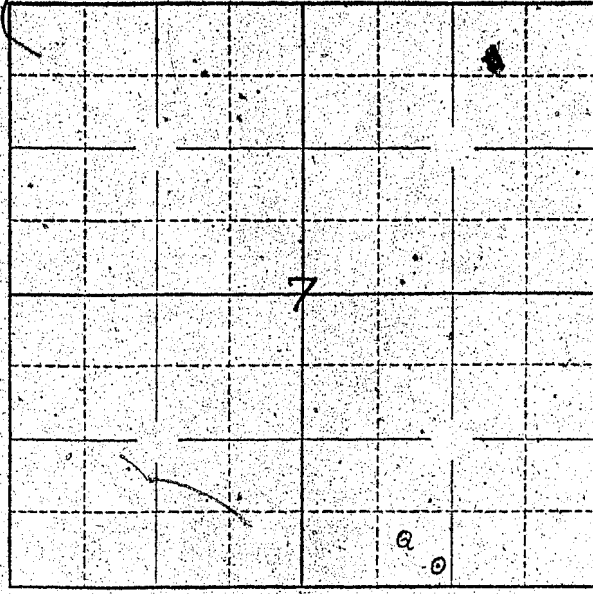

Locate well and acreage of irrigated land on plat.

Scale: $\frac{1}{4}$ " = 1 Mile

STATE OF OREGON

County of Linn } ss.

I, Gus Leder being first duly sworn, do hereby certify that I have read the foregoing Registration Statement and that all of the items therein contained are true to the best of my knowledge and belief.

Gus Leder
(Signature of Registrant)

Subscribed and sworn to before me this 16 day of July, 1935

My commission expires Jan. 3 - 1941 W. J. Simpson
(Notary Public)

(SEAL)

CERTIFICATE OF REGISTRATION

STATE OF OREGON

Marion } ss.
County of Marion

This is to certify that the foregoing Registration Statement was received in the office of the State Engineer on the 17 day of July, 1935, at 800 o'clock A.M. and has been duly recorded in said office in Book No. 16 of Registration Statements on page OR 3828

Witness my hand this 17 day of December, 1935

Henry A. Stanley
(State Engineer)

By _____ (Deputy)

GR 3828

15.22