

RECEIVED
JUL 17 1958

STATE ENGINEER
SALEM, OREGON

Registration No. GR 2232

Certificate No. GR 3839

Registration Statement

OF CLAIMANT OF RIGHT TO APPROPRIATE GROUND WATER

TO THE STATE ENGINEER OF OREGON:

FRED A. WEBER

I, ~~XXXXXXXXXX~~

of 2140 Broadway Albany County of Linn
(Mailing address)

State of Oregon, do hereby make application for a certificate of registration as evidence of a right to appropriate ground water.

- 1. Source from which water is withdrawn is pump well
(Flowing well, pump well, infiltration trench, or tunnel)
- 2. Location is: .1 mile southwest of Albany, Oregon
(Approximate distance and direction from nearest city or town)

and is more particularly described as follows:

(a) West .915 ft., North 10 1/2 Degree, 1344 ft. from S.E. corner of Geo. Cline D.L. 084
(Give distance and bearing to corner of section or other legal subdivision)
being within 1 acre of Sec. 13, Twp. 11 S., Rge. 4 W.
(Smallest legal subdivision) (N. or S.) (E. or W.)

or (b) within limits of recorded platted property, town or city:
in Lot _____, Block _____ of _____
(Name of plat or addition)
County of _____
(If within city or town, give name)

3. Construction Work was begun on 8-15-1950; was completed on 8-25-1950
(Date) (Date)

and the ground water claimed was first used for the purposes set out below on 8-30-1950
(Date)
since which time the water has been used c. continuously
(Continuously or intermittently)
from 8-30-1950 to present time
(Date) (Date)

4. Quantity of water claimed and used is 13 gallons per minute; _____ acre feet per year.

5. Purpose or Purposes for which water is used domestic and irrigation
of pasture and orchard.
(Domestic, irrigation, municipal, manufacturing, industrial, etc.)

6. Description of Well: Depth 92 feet; Type Drilled
(Dug or drilled)
diameter 4 inches. Elevation of ground at well site 218 feet, mean sea level
(As near as known)
Depth to water table 20 feet.

7. Capacity of Well: unknown g.p.m. with _____ feet drawdown.
_____ g.p.m. with _____ feet drawdown.


Date of test _____

If Flowing Well: Measured discharge _____ g.p.m. on _____
(Date)

Shut-in pressure at ground surface _____ lbs. per sq. in. on _____
(Date)

Water is controlled by _____
(Cap, valve, etc.)

Township 11.5 Range 4W W.M.
North

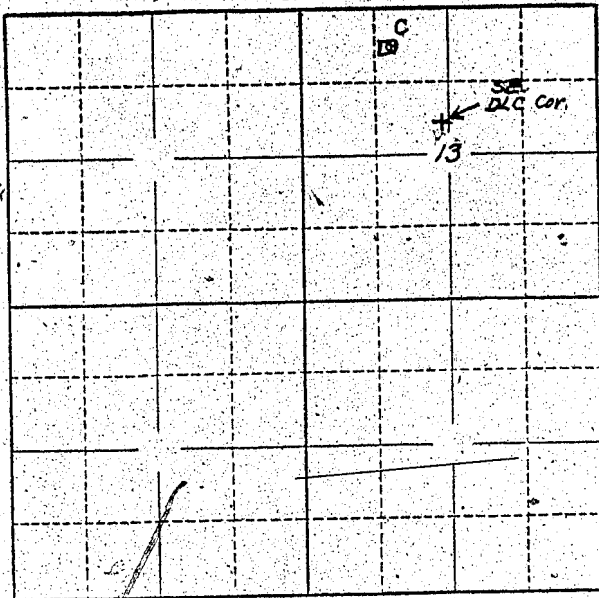

Locate well and acreage of irrigated land on plat.
Scale: 2" = 1 Mile

STATE OF OREGON

County of Linn } ss.

I, Fred A. Weber, being first duly sworn, do hereby certify that I have read the foregoing Registration Statement and that all of the items therein contained are true to the best of my knowledge and belief.

Fred A. Weber
(Signature of Registrant)

Subscribed and sworn to before me this 16th day of July, 1958

My commission expires April 11, 1960

Madeline L. Amos
(Notary Public)

(SEAL)

CERTIFICATE OF REGISTRATION

STATE OF OREGON

County of Marion } ss.

This is to certify that the foregoing Registration Statement was received in the office of the State Engineer on the 17th day of July, 1958, at 2:00 o'clock P. M. and has been duly recorded in said office in Book No. 16 of Registration Statements on page GR 3839

Witness my hand this 26th day of December, 1959

Lewis A. Stanley
(State Engineer)

By _____ (Deputy)

#15.00