

RECEIVED
JUL 17 1958
STATE ENGINEER
SALEM, OREGON
RECEIVED
JAN 29 1959
STATE ENGINEER
SALEM, OREGON

Registration No. GR-2234
Certificate No. GR 2138

Registration Statement

DECLAIMANT OF RIGHT TO APPROPRIATE GROUND WATER

TO THE STATE ENGINEER OF OREGON:

I, Jesse Roth
of Jefferson, Oregon County of Marion
State of Oregon, do hereby make application for a certificate of registration as evidence
of a right to appropriate ground water.

1. Source from which water is withdrawn is pump well
(Flowing well, pump well, infiltration trench, or tunnel)
2. Location is: 1 1/2 miles northeast of Jefferson
(Approximate distance and direction from nearest city or town)

and is more particularly described as follows:

- (a) 700 ft South and 100 ft west of NE corner of section
(Give distance and bearing to corner of section or other legal subdivision)
- being within Marion county of Sec. 1, Twp. 10S, Rge. 3W
(Smallest legal subdivision) (N. or S.) (E. or W.)
- or (b) within limits of recorded platted property, town or city:

in Lot _____, Block _____ of _____
(Name of plat or addition)

County of _____
(If within city or town, give name)

3. Construction Work was begun on July 20, 1950, was completed on July 25, 1950
(Date) (Date)

and the ground water claimed was first used for the purposes set out below on June 15, 1951
(Date)

since which time the water has been used each year
(Continuously or intermittently)

from May 15 to Sept. 30
(Date) (Date)

4. Quantity of water claimed and used is 370 gallons per minute; 30 acre
feet per year.

5. Purpose or Purposes for which water is used _____

irrigation of farm crops
(Domestic, irrigation, municipal, manufacturing, industrial, etc.)

6. Description of Well: Depth 28 feet. Type drilled
(Dug or drilled)

diameter 12 inches. Elevation of ground at well site 200 feet, mean sea level.
(As near as known)

Depth to water table 8 feet.

7. Capacity of Well: _____ g.p.m. with _____ feet drawdown.
_____ g.p.m. with _____ feet drawdown.

Date of test July 20, 1953

If Flowing Well: Measured discharge _____ g.p.m. on _____
(Date)

Shut-in pressure at ground surface _____ lbs. per sq. in. on _____
(Date)

Water is controlled by _____
(Cap, valve, etc.)

12 inch diameter 0 from 28 feet

inch diameter from to feet

inch diameter from to feet

inch diameter from to feet

just straight casing.

4 per foot 4 rows from 12 to 20
(Number per foot and size of perforations, or describe screen)


from to
from to
from to
from to

[illegible]

If log of well is not available, give name and address of driller. Art Clinton
Route 1 Box 2 Independence Oregon

GR 2138

Township 10th Range 2+3 W.M.
North

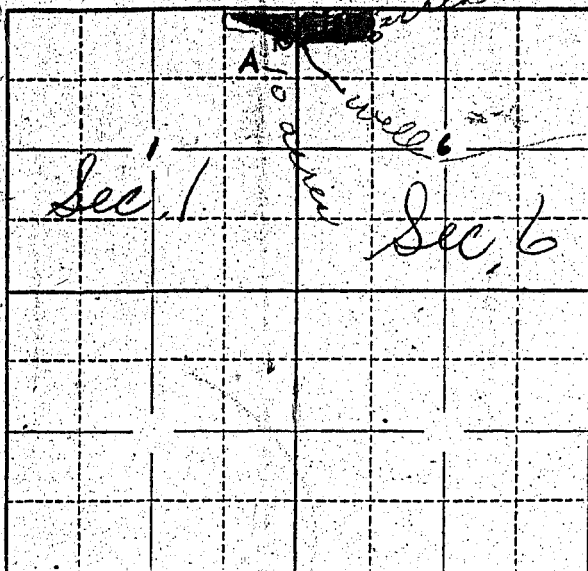

is about
700 ft. South
and 100 ft
West of NE
Corner of
Section 11

Locate well and acreage of irrigated land on plat.

Scale: 2" = 1 Mile

STATE OF OREGON

County of Marion } ss.

I, Jesse Roth, being first duly sworn, do hereby certify that I have read the foregoing Registration Statement and that all of the items therein contained are true to the best of my knowledge and belief.

Subscribed and sworn to before me this 15 day of July, 1958.

My commission expires

NOTARY PUBLIC FOR OREGON
My Commission Expires April 18, 1961

Jesse Roth
(Signature of Registrant)

John B. Lutton
(Notary Public)

(SEAL)

CERTIFICATE OF REGISTRATION

STATE OF OREGON

County of Marion } ss.

This is to certify that the foregoing Registration Statement was received in the office of the State Engineer on the 17th day of July, 1958, at 8:00 o'clock A. M. and has been duly recorded in said office in Book No. 9 of Registration Statements on page GR-2138.

Witness my hand this 10th day of March, 19 59.

Lewis A. Stanley
(State Engineer)

By

(Deputy)

GR-2138