

RECEIVED
JUN 17 1958
STATE ENGINEER
SALEM, OREGON

Registration No. GR - 2239
Certificate No. GR 2140

Registration Statement

OF CLAIMANT OF RIGHT TO APPROPRIATE GROUND WATER

TO THE STATE ENGINEER OF OREGON:

I, Alan & Vivienne Ewing (EWING, S BLUEBERRY FARM)

of 95 Spring Creek Drive, Eugene Oregon County of Lane

State of Oregon, do hereby make application for a certificate of registration as evidence of a right to appropriate ground water.

1. Source from which water is withdrawn is Pump Well
(Flowing well, pump well, infiltration trench, or tunnel)

2. Location is: Six miles North of Eugene
(Approximate distance and direction from nearest city or town)

and is more particularly described as follows: 2380 ft east & 720 feet South from NW corner Section 2,

(a) 400 ft. North then 100 ft. East of S.W. Corner of Lot #1 Hansen Riverview Acres.
As recorded in Vol. 4 Page 11 (Give distance and bearing to corner of section or other legal subdivision)

being within Lane County Oregon, Plat Records Sec 2, Twp. 17 S., Rge. 4 WEST
(Smallest legal subdivision) (R. or S.) (R. or W.)

or (b) within limits of recorded platted property, town or city:

in Lot _____, Block _____ of _____
(Name of plat or addition)

County of _____
(If within city or town, give name)

3. Construction Work was begun on May 23, 1955; was completed on May 23, 1955
(Date) (Date)

and the ground water claimed was first used for the purposes set out below on June 1st 1955
(Date)

since which time the water has been used Continuously May thru Sept Each year
(Continuously or Intermittently)

from JUNE 1st 1955 to PRESENT DATE
(Date) (Date)

4. Quantity of water claimed and used is 120 gallons per minute; _____ acre feet per year.

5. Purpose or Purposes for which water is used Irrigation of blueherrys

(Domestic, irrigation, municipal, manufacturing, industrial, etc.)

6. Description of Well: Depth 20 feet. Type Driven
(Dug or drilled)

diameter Two inches. Elevation of ground at well site 300 feet, mean sea level.
(As near as known)

Depth to water table 10 feet.

7. Capacity of Well: Unknown g.p.m. with Unknown feet drawdown.

_____ g.p.m. with _____ feet drawdown.


Date of test _____

If Flowing Well: Measured discharge _____ g.p.m. on _____
(Date)

Shut-in pressure at ground surface _____ lbs. per sq. in. on _____
(Date)

Water is controlled by _____
(Cap, valve, etc.)

Township 175 Range 4W W.M.
North

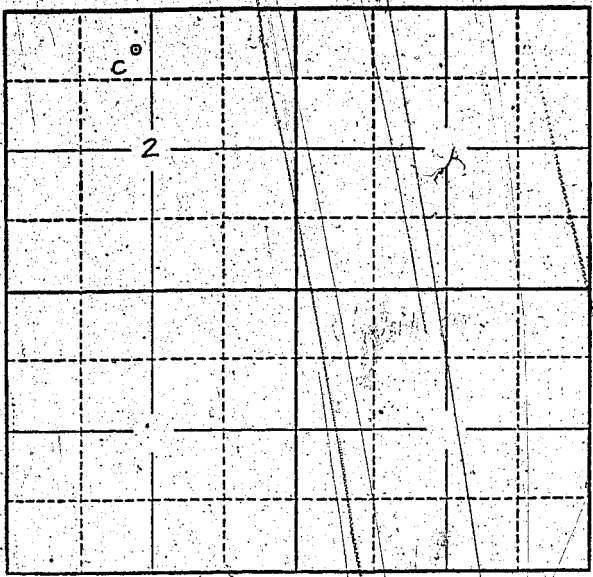

Locate well and acreage of irrigated land on plat.
Scale: 2" = 1 Mile

STATE OF OREGON }
County of Lane } ss.

I, Allen J. Emery + Valerine Emery, being first duly sworn, do hereby certify that I have read the foregoing Registration Statement and that all of the items therein contained are true to the best of my knowledge and belief.

Allen J. Emery
(Signature of Registrant)

Subscribed and sworn to before me this 15th day of July, 1958

NOTARY PUBLIC FOR OREGON

My commission expires Nov. 4, 1960

D. Sullivan
(Notary Public)

(SEAL)

CERTIFICATE OF REGISTRATION

STATE OF OREGON }
County of Marion } ss.

This is to certify that the foregoing Registration Statement was received in the office of the State Engineer on the 17th day of July, 1958, at 8:00 o'clock A. M. and has been duly recorded in said office in Book No. 9 of Registration Statements on page GR-2140

Witness my hand this 10th day of March, 1959

Laura A. Stanley
(State Engineer)

By _____
(Deputy)

\$15.00