RECEIVED
JUL 17 1956
STATE ENGINEER
SALEM, OREGON

REGISTRATION NO. GR-224
CERTIFICATE NO. GR-231

Registration Statement

OF CLAIMANT OF RIGHT TO APPROPRIATE GROUND WATER

(Under Chapter 708, Oregon Laws 1955.)

TO THE STATE ENGINEER OF OREGON:

I, Edwin B. Oleson,
of Rt. 5 - Bx 635 - Oregon City County of Clackamas
State of Oregon, do hereby make application for a certificate of registration as evidence of a right to appropriate ground water.

1. **Source** from which water is withdrawn is Pump well (Flowing well, pump well, infiltration trench, or tunnel)
2. **Location** is: about 7 miles East of Oregon city on Redland Beaver Rd (Approximate distance and direction from nearest city or town)

and is more particularly described as follows:

(a) 1000 feet south and 950 feet west from North 1/4 corner section 31 (Give distance and bearing to corner of section or other legal subdivision)
being within Part of the NE 1/4 of the NW 1/4 (Smallest legal subdivision) of Sec. 31, Twp. 2 S (N. or S.), Rge. 3 E (E. or W.)

or (b) within limits of recorded platted property, town or city:
in Lot ....., Block ..... of ..... (Name of plat or addition)
..... (If within city or town, give name) County of Clackamas

3. **Construction Work** was begun on May 9, 1949 (Date); was completed on March 9 - 1950 (Date)
and the ground water claimed was first used for the purposes set out below on March 9, 1950 (Date),
since which time the water has been used for domestic + irrigation (Continuously or intermittently)
from April 1 - 1950 (Date) to Nov 7 - 1955 (Date)
4. **Quantity** of water claimed and used is 40 gallons per minute; 10 acre feet per year.
5. **Purpose or Purposes** for which water is used domestic + pastures (Domestic, irrigation, municipal, manufacturing, industrial, etc.)
6. **Description of Well:** Depth 79 feet. Type drilled (Dug or drilled)
diameter 6 inches. Elevation of ground at well site 400 (As near as known) feet, mean sea level.
Depth to water table 24 feet.
7. **Capacity of Well:** 18 g.p.m. with 37 1/2 feet drawdown.
45 g.p.m. with 75 feet drawdown.
Date of test June 30 - 1949

If Flowing Well: Measured discharge ..... g.p.m. on ..... (Date)
Shut-in pressure at ground surface ..... lbs. per sq. in. on ..... (Date)
Water is controlled by ..... (Cap, valve, etc.)

8. **Casing:** (Give diameter, commercial specifications and depth below ground surface of each casing size.)

6 inch diameter from 0 to 79 feet

..... inch diameter from ..... to ..... feet

..... inch diameter from ..... to ..... feet

..... inch diameter from ..... to ..... feet

Describe and show depth of shoe, plug, adapter, liner or other details: None

9. **Perforated Casings or Screens:**

None (Number per foot and size of perforations, or describe screen) from ..... to .....

..... from ..... to .....

..... from ..... to .....

..... from ..... to .....

10. **Log of Well:** (Describe each stratum or formation clearly, indicate if water bearing, and give thickness and depth as indicated.)

MATERIAL	Thickness (Feet)	Depth to Bottom (Feet)
the formation all the way down was mostly what is know as cement sand.		

GR-231A

If log of well is not available, give name and address of driller, Steinamman Bros 8332 S.E. 16th ave Portland Oregon

11. **Infiltration Trench:** Covered or open .....

Dimensions: Length ..... ft. Minimum depth ..... ft. Maximum depth ..... ft.

Bottom width ..... ft. Discharge ..... g.p.m. Date of test .....

12. **Tunnel:** Type of lining .....

Dimensions: .....
(Length, course, and cross sectional size)

Position of water bearing stratum with reference to portal of tunnel .....

Log of tunnel: (Preceding table for log of well may be used, if desired. Give footage from portal and character of materials, as pertinent.)

13. **Pumping Equipment:**

(a) Pump Cook Turbette (Make, type and size) Capacity 40 g.p.m. at 79 ft

(b) Motor Electric 3 hp (Type and horsepower)

14. Location of area irrigated or to be irrigated, or place of use if for purposes other than irrigation.

Township North or South	Range E. or W. of Willamette Meridian	Section	Forty-acre Tract	Number Acres To Be Irrigated	Date of Reclamation
2 S	3 E	31	NE 1/4 of NW 1/4	10	March 9, 1950

15. If the ground water supply is supplemental to an existing water supply, identification of any application for a permit, permit, certificate or adjudicated right to appropriate water made or held by the registrant.

.....

.....

GR-231 B

Township 28 Range 3E, W.M.

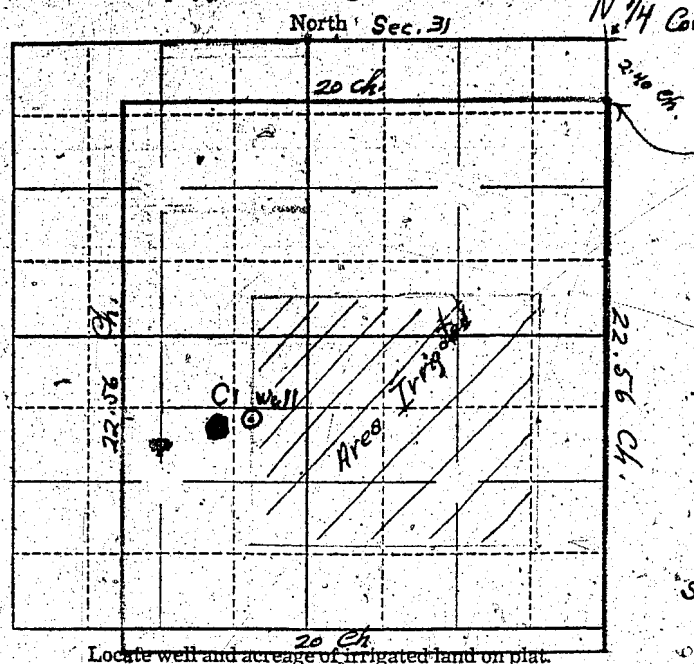

~~Locate well and acreage of irrigated land on plat.~~

Scale: ~~2" = 1 Mile~~
1" = 400 ft.

STATE OF OREGON
County of Clackamas } ss.

I, Edwin B Olson, being first duly sworn, do hereby certify that I have read the foregoing Registration Statement and that all of the items therein contained are true to the best of my knowledge and belief.

Edwin B Olson
(Signature of Registrant)

Subscribed and sworn to before me this 14th day of November, 1955.

My commission expires March 27, 1957 — A. J. Hagendorfer
(Notary Public)

(SEAL)

CERTIFICATE OF REGISTRATION

STATE OF OREGON
County of Marion } ss.

This is to certify that the foregoing Registration Statement was received in the office of the State Engineer on the 7th day of August, 1956, at 8 o'clock A. M. and has been duly recorded in said office in Book No. 2 of Registration Statements on page GR-231 C

~~Construction shall be completed by x-x-x-x-x-x-x-x-x-x-x-19x-x-x, and the water completely applied to beneficial use by x-x-x-x-x-x-x-x-x-x-x-19-x-x.~~

Witness my hand this 23rd day of November, 1956.

Lewis A. Stanley
(State Engineer)

By .....
(Deputy)

GR-231C