

RECEIVED
STATE ENGINEER
SALEM, OREGON

Registration No. GR - 2249

Certificate No. GR - 3863

Registration Statement

OF CLAIMANT OF RIGHT TO APPROPRIATE GROUND WATER

TO THE STATE ENGINEER OF OREGON:

I, Neil E. Vanderburg

of Rt. 3, Box 545, Corvallis County of Benton

State of Oregon, do hereby make application for a certificate of registration as evidence of a right to appropriate ground water.

1. Source from which water is withdrawn is Pump Well
(Flowing well, pump well, infiltration trench, or tunnel)

2. Location is: 10 South + East of Corvallis
(Approximate distance and direction from nearest city or town)

and is more particularly described as follows:

(a) 173' North + 191' east from the NW Cor. Abel Herbert D.L.C. #60
(Give distance and bearing to corner of section or other legal subdivision)

being within SE4 NE4 of Sec. 13, Twp. 13S, Rge. 4W
(Smallest legal subdivision) (N. or S.) (E. or W.)

or (b) within limits of recorded platted property, town or city:

in Lot _____, Block _____ of _____
(Name of plat or addition)

County of _____
(If within city or town, give name)

3. Construction ~~work~~ was begun on May 1952; was completed on 1952
(Date) (Date)

and the ground water claimed was first used for the purposes set out below on 1952
(Date)

since which time the water has been used continuously during season
(Continuously or intermittently)

from May to Sept.
(Date) (Date)

4. Quantity of water claimed and used is 225 gallons per minute; 28 acre feet per year.

5. Purpose or Purposes for which water is used Irrigation
(Domestic, irrigation, municipal, manufacturing, industrial, etc.)

6. Description of Well: Depth 32 feet. Type Drilled
(Dug or drilled)

diameter 4 inches. Elevation of ground at well site 250 feet, mean sea level.
(As near as known)

Depth to water table 14 feet.

7. Capacity of Well: 300 g.p.m. with 2 feet drawdown.

_____ g.p.m. with _____ feet drawdown.

Date of test _____

If Flowing Well: Measured discharge _____ g.p.m. on _____
(Date)

Shut-in pressure at ground surface _____ lbs. per sq. in. on _____
(Date)

Water is controlled by _____
(Cap, valve, etc.)

8. Casing: (Give diameter, commercial specifications and depth below ground surface of each casing size.)

4" inch diameter for Well 32' from to feet
..... inch diameter from to feet
..... inch diameter from to feet
..... inch diameter from to feet

Describe and show depth of shoe, plug, adapter, liner or other details:
.....
.....

9. Perforated Casings or Screens:

(Number per foot and size of perforations, or describe screen)

from to
from to
from to
from to

10. Log of Well: (Describe each stratum or formation clearly, indicate if water bearing, and give thickness and depth as indicated.)

MATERIAL	Thickness (Feet)	Depth to Bottom (Feet)

✓ If log of well is not available, give name and address of driller. Bill Howell

Philomath Oregon

11. Infiltration Trench: Covered or open
 Dimensions: Length ft. Minimum depth ft. Maximum depth ft.
 Bottom width ft. Discharge g.p.m. Date of test

12. Tunnel: Type of lining
 Dimensions:
(Length, course, and cross sectional size)
 Position of water bearing stratum with reference to portal of tunnel

Log of tunnel: (Preceding table for log of well may be used, if desired. Give footage from portal and character of materials, as pertinent.)


13. Pumping Equipment:
 (a) Pump Fairbanks Morse Combination Capacity 225 g.p.m.
(Make, type and size)
 (b) Motor 7/8 H.P. - Single Phase
(Type and horsepower)

14. Location of area irrigated or to be irrigated, or place of use if for purposes other than irrigation.

Township North or South	Range E. or W. of Willamette Meridian	Section	Forty-acre Tract	Number Acres To Be Irrigated	Date of Reclamation
13S	4W	18	SW 1/4 NW 1/4	1.40	1952

15. If the ground water supply is supplemental to an existing water supply, identification of any application for a permit, permit, certificate or adjudicated right to appropriate water made or held by the registrant.

Township 13S Range 11E W.M.
North

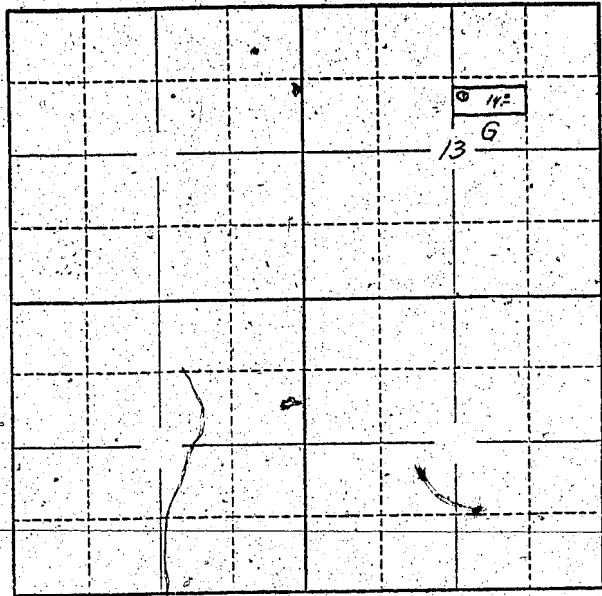

See 32461

Locate well and acreage of irrigated land on plat.
Scale: 2" = 1 Mile

STATE OF OREGON

County of Benton } ss.

I, Neil S. Vandenberg, being first duly sworn, do hereby certify that I have read the foregoing Registration Statement and that all of the items therein contained are true to the best of my knowledge and belief.

Neil S. Vandenberg
(Signature of Registrant)

I Subscribed and sworn to before me this 16th day of July, 1958

My commission expires Dec 11 1959
(Notary Public) for the State of Oregon
My Commission Expires Dec. 11, 1959

(SEAL)

CERTIFICATE OF REGISTRATION

STATE OF OREGON

County of Marion } ss.

This is to certify that the foregoing Registration Statement was received in the office of the State Engineer on the 17th day of July, 1958, at 8:00 o'clock A.M. and has been duly recorded in said office in Book No. 16 of Registration Statements on page GR-3863

Witness my hand this 28th day of December, 1959

Laura A. Stanley
(State Engineer)

By _____ (Deputy)

\$15.00

GR. 3863