

RECEIVED

MAR 10 1958

STATE ENGINEER  
SALEM, OREGON

Registration No. GR-2253

Certificate No. GR 3808

# Registration Statement

## OF CLAIMANT OF RIGHT TO APPROPRIATE GROUND WATER

TO THE STATE ENGINEER OF OREGON:

I, WM BADE

of MILTON FREE WATER County of UMATILLA  
(Mailing address)

State of \_\_\_\_\_, do hereby make application for a certificate of registration as evidence of a right to appropriate ground water.

1. Source from which water is withdrawn is PUMP WELL  
(Flowing well, pump well, infiltration trench, or tunnel)

2. Location is: FIVE-1/4 W OF MILTON FREE WATER  
(Approximate distance and direction from nearest city or town)

and is more particularly described as follows: about 800 feet South & 560 feet west from N 1/4 corner Section 21

(a) S W N W LESS N 17 1/2 RODS OF W 15 RODS  
(Give distance and bearing to corner of section or other legal subdivision)

being within NE 1/4 of N.W. 1/4 of Sec. 21, Twp. 6 N, Rge. 35 E  
(Smallest legal subdivision) (N. or S.) (E. or W.)

or (b) within limits of recorded platted property, town or city:

in Lot \_\_\_\_\_, Block \_\_\_\_\_ of \_\_\_\_\_  
(Name of plat or addition)

County of \_\_\_\_\_

(If within city or town, give name)

3. Construction Work was begun on 1923; was completed on 1924  
(Date) (Date)

and the ground water claimed was first used for the purposes set out below on 1925  
(Date)

since which time the water has been used CONTINUOUSLY  
(Continuously or intermittently)

from 1925 to 1957  
(Date) (Date)

4. Quantity of water claimed and used is 72.72 gallons per minute; NOT KNOWN acre-feet per year.  
ca 125

5. Purpose or Purposes for which water is used

IRRIGATION  
(Domestic, irrigation, municipal, manufacturing, industrial, etc.)

6. Description of Well: Depth 33 feet. Type DUG  
(Dug or drilled)

diameter 7.2 inches. Elevation of ground at well site 1200 feet, mean sea level.  
(As near as known)

Depth to water table \_\_\_\_\_ feet.

7. Capacity of Well: 150 g.p.m. with 4 feet drawdown.

\_\_\_\_\_ g.p.m. with \_\_\_\_\_ feet drawdown.

Date of test NOT KNOWN

If Flowing Well, Measured discharge \_\_\_\_\_ g.p.m. on \_\_\_\_\_  
(Date)

Shut-in pressure at ground surface \_\_\_\_\_ lbs. per sq. in. on \_\_\_\_\_  
(Date)


Water is controlled by \_\_\_\_\_  
(Cap, valve, etc.)





from West line 31 rods East  
from South 3 rods North

Township 6 N Range 35 E W.M.  
North

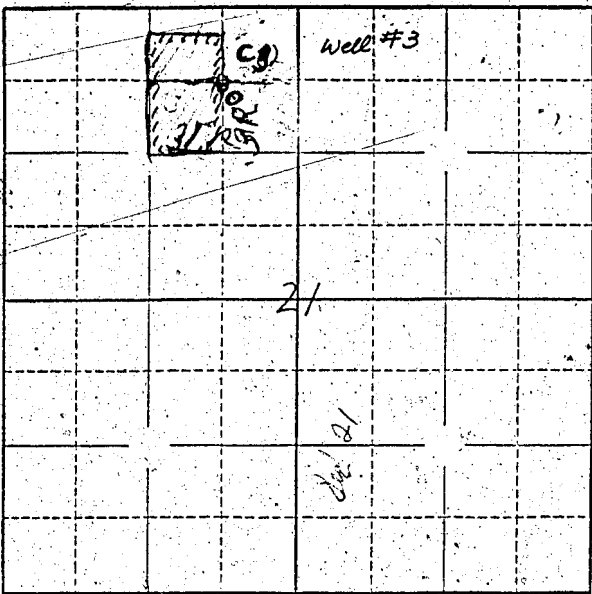

Locate well and acreage of irrigated land on plat.

Scale:  $\frac{1}{4}$ " = 1 Mile

STATE OF OREGON

County of Umatilla } ss.

I, William G. Bock, being first duly sworn, do hereby certify that I have read the foregoing Registration Statement and that all of the items therein contained are true to the best of my knowledge and belief.

William G. Bock  
(Signature of Registrant)

Subscribed and sworn to before me this 6<sup>th</sup> day of March, 1958

My commission expires Sept. 6, 19 John L. Miller  
(Notary Public)

(SEAL)

**CERTIFICATE OF REGISTRATION**

STATE OF OREGON

County of Marion } ss.

This is to certify that the foregoing Registration Statement was received in the office of the State Engineer on the 10 day of March, 1958, at 8:00 o'clock A. M. and has been duly recorded in said office in Book No. 16 of Registration Statements on page GR 3808.

Witness my hand this 4<sup>th</sup> day of December, 1959

Laura A. Stanley  
(State Engineer)

By \_\_\_\_\_  
(Deputy)

GR 3808

\$15.00