

Registration Statement

OF CLAIMANT OF RIGHT TO APPROPRIATE GROUND WATER

TO THE STATE ENGINEER OF OREGON:

I, MAURICE HENRY Goodrich

of RT #1 Dayton Oregon County of Yamhill

State of OREGON, do hereby make application for a certificate of registration as evidence of a right to appropriate ground water.

1. Source from which water is withdrawn is Pump Wells

2. Location is: 6 mile South of Dayton

and is more particularly described as follows:

(a) 2350 feet north & 600 feet west from S.E. corner Section 8

being within NEL/4 of SE 1/4 of Sec. 8, Twp. 5 S, Rge. 3 W

or (b) within limits of recorded platted property, town or city:

in Lot _____, Block _____ of _____

County of _____

3. Construction Work was begun on April 1950; was completed on April 1950

and the ground water claimed was first used for the purposes set out below on June 1950

since which time the water has been used Intermittently each year

from June to Oct. 1957

4. Quantity of water claimed and used is 200 gallons per minute; _____ acre feet per year.

5. Purpose or Purposes for which water is used Irrigation

6. Description of Well: Depth 96 feet. Type Borehole

diameter 7 inches. Elevation of ground at well site 152 feet, mean sea level.

Depth to water table 36 feet.

7. Capacity of Well: 205 g.p.m. with 60 feet drawdown.

_____ g.p.m. with _____ feet drawdown.

Date of test _____

If Flowing Well: Measured discharge _____ g.p.m. on _____

Shut-in pressure at ground surface _____ lbs. per sq. in. on _____

Water is controlled by _____

8. Casing: (Give diameter, commercial specifications and depth below ground surface of each casing size.)

8 inch diameter *steel casing* from 0 to 96 feet
 inch diameter from to feet
 inch diameter from to feet
 inch diameter from to feet

Describe and show depth of shoe, plug, adapter, liner or other details:


9. Perforated Casings or Screens:

yes from 54 to 96
(Number per foot and size of perforations, or describe screen)
 from to
 from to
 from to

10. Log of Well: (Describe each stratum or formation clearly, indicate if water bearing, and give thickness and depth as indicated.)

MATERIAL	Thickness (Feet)	Depth to Bottom (Feet)
<i>Not available</i>		

Township 5 South Range 3 W W.M. Sec 7
North

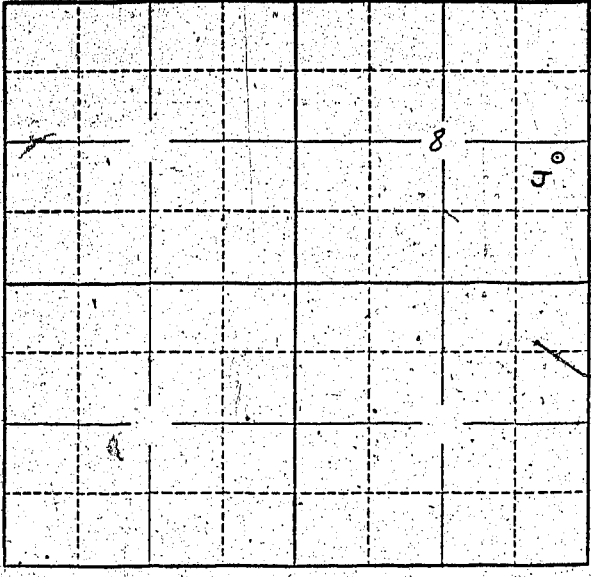

Locate well and acreage of irrigated land on plat.
Scale: 2" = 1 Mile

STATE OF OREGON }
County of Marion } ss.

I, _____, being first duly sworn, do hereby certify that I have read the foregoing Registration Statement and that all of the items therein contained are true to the best of my knowledge and belief.

Maurice Henry Goodrich
(Signature of Registrant)

Subscribed and sworn to before me this 17th day of July, 1958.

My commission expires 12th June 1961 Wm. S. Bartholomew
(Notary Public)

(SEAL)

CERTIFICATE OF REGISTRATION

STATE OF OREGON }
County of Marion } ss.

This is to certify that the foregoing Registration Statement was received in the office of the State Engineer on the 17th day of July, 1958, at 2:45 o'clock P.M. and has been duly recorded in said office in Book No. 10 of Registration Statements on page GR 2157.

Witness my hand this 10th day of March, 1959

Laura A. Stanley
(State Engineer)

By _____ (Deputy)

\$ 16.50