

# Registration Statement

## OF CLAIMANT OF RIGHT TO APPROPRIATE GROUND WATER

TO THE STATE ENGINEER OF OREGON:

I, Ruel Bradford  
of Rt. 1 Box 86 Gervais County of Marion  
(Mailing address)  
State of Oregon, do hereby make application for a certificate of registration as evidence of a right to appropriate ground water.

1. Source from which water is withdrawn is Pump Well  
(Flowing well, pump well, infiltration trench, or tunnel)

2. Location is: 3 Miles Northwest of Brooks, Oregon  
(Approximate distance and direction from nearest city or town)

and is more particularly described as follows: From the N.W. cor. of Allanson Beers D.L.C. #38

(a) North 56 deg. 30' East 1362 ft. and South 35 deg. 15' East 865 ft.

being within NE 1/4 of SW 1/4 of Sec. 2, Twp. 6 South, Rge. 3 West  
(Give distance and bearing to corner of section or other legal subdivision)  
(Smallest legal subdivision) (N. or S.) (E. or W.)

or (b) within limits of recorded platted property, town or city:

in Lot \_\_\_\_\_, Block \_\_\_\_\_ of \_\_\_\_\_  
(Name of plat or addition)  
County of \_\_\_\_\_  
(If within city or town, give name)

3. Construction Work was begun on July 10, 1950; was completed on July 15, 1950  
(Date) (Date)

and the ground water claimed was first used for the purposes set out below on 1950  
(Date)

since which time the water has been used intermittently  
(Continuously or intermittently)

from April to Sept  
(Date) (Date)

4. Quantity of water claimed and used is 15 gallons per minute; \_\_\_\_\_ acre feet per year.

5. Purpose or Purposes for which water is used Domestic & Irrigation

(Domestic, irrigation, municipal, manufacturing, industrial, etc.)

6. Description of Well: Depth 41 feet. Type Drilled (Cable Tools)  
(Dug or drilled)

diameter 6 inches. Elevation of ground at well site 117 feet, mean sea level.  
(As near as known)

Depth to water table 22 feet.

7. Capacity of Well: 40 g.p.m. with 2 feet drawdown. Bailer Test

g.p.m. with \_\_\_\_\_ feet drawdown.

Date of test July 15, 1950

If Flowing Well: Measured discharge \_\_\_\_\_ g.p.m. on \_\_\_\_\_  
(Date)

Shut-in pressure at ground surface \_\_\_\_\_ lbs. per sq. in. on \_\_\_\_\_  
(Date)

Water is controlled by \_\_\_\_\_  
(Cap. valve, etc.)

8. Casing: (Give diameter, commercial specifications and depth below ground surface of each casing size.)

6 inch diameter ..... from <sup>Top</sup> to 41 feet  
 . inch diameter ..... from ..... to ..... feet  
 . inch diameter ..... from ..... to ..... feet  
 . inch diameter ..... from ..... to ..... feet

Describe and show depth of shoe, plug, adapter, liner or other details: .....

~~Threaded & Coupled Pipe~~ ..... ~~Welded Spring Steel Shoe~~ .....

9. Perforated Casings or Screens:

18 Perforations  $\frac{1}{2}$ " Wide 6" Long ..... from 34 to 40  
(Number per foot and size of perforations, or describe screen)  
 (Acetylene Torch) ..... from ..... to .....  
 ..... from ..... to .....  
 ..... from ..... to .....

10. Log of Well: (Describe each stratum or formation clearly, indicate if water bearing, and give thickness and depth as indicated.)

MATERIAL	Thickness (Feet)	Depth to Bottom (Feet)
Top Soil	0	2
Yellow clay	2	24
Brown Sand & Gravel (Water)	24	41

If log of well is not available, give name and address of driller.

Emil J. Beier 7555 O'Neil Road Salem, Oregon

11. Infiltration Trench: Covered or open

Dimensions: Length ft. Minimum depth ft. Maximum depth ft.

Bottom width ft. Discharge g.p.m. Date of test

12. Tunnel: Type of lining

Dimensions: (Length, course, and cross sectional size)

Position of water bearing stratum with reference to portal of tunnel

Log of tunnel: (Preceding table for log of well may be used, if desired. Give footage from portal and character of materials, as pertinent.)

13. Pumping Equipment:

(a) Pump 1 1/2 H.P. Jet Pump Capacity 15 g.p.m. (Make, type and size)

(b) Motor Single phase Electric (Type and horsepower)


14. Location of area irrigated or to be irrigated, or place of use if for purposes other than irrigation.

Table with 6 columns: Township North or South, Range E. or W. of Willamette Meridian, Section, Forty-acre Tract, Number Acres To Be Irrigated, Date of Reclamation. Handwritten entry: 6S, 3W, 2, NE 1/4 SW 1/4, 2.2, 1950.

15. If the ground water supply is supplemental to an existing water supply, identification of any application for a permit, permit, certificate or adjudicated right to appropriate water made or held by the registrant.

None

Township 6S Range 3W, W.M.  
North

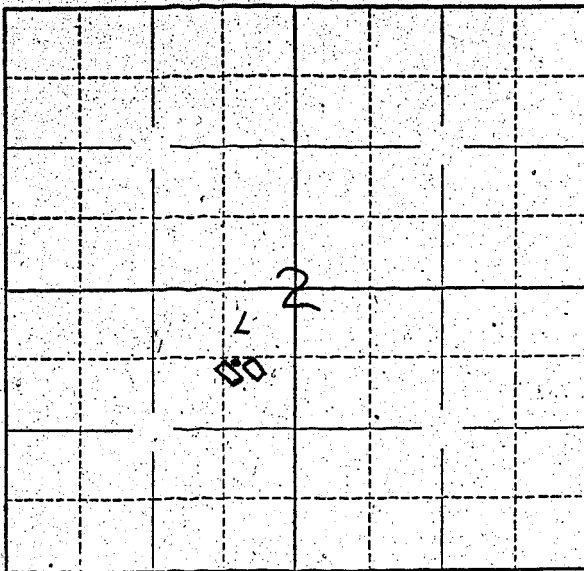

Locate well and acreage of irrigated land on plat.

Scale: 2" = 1 Mile  
4"

STATE OF OREGON

County of Marion

} ss.

I, \_\_\_\_\_, being first duly sworn, do hereby certify that I have read the foregoing Registration Statement and that all of the items therein contained are true to the best of my knowledge and belief.

Ruel Bradford  
(Signature of Registrar)

Subscribed and sworn to before me this 17th day of July, 19 58

My commission expires 12th June 1961

Wm. S. Bartholomew  
(Notary Public)

(SEAL)

CERTIFICATE OF REGISTRATION.

STATE OF OREGON

County of Marion

} ss.

This is to certify that the foregoing Registration Statement was received in the office of the State Engineer on the 17th day of July, 19 58, at 3:15 o'clock P. M. and has been duly recorded in said office in Book No. 10 of Registration Statements on page 68-2159

Witness my hand this 10th day of March

19 59

Stuart A. Stanley  
(State Engineer)

By \_\_\_\_\_

(Deputy)

GR - 2159

1500