

Registration Statement

OF CLAIMANT OF RIGHT TO APPROPRIATE GROUND WATER

TO THE STATE ENGINEER OF OREGON:

I, Robert Schroeder

of 1855 Kelzer Road Salem, Oregon

County of Marion

State of Oregon

, do hereby make application for a certificate of registration as evidence of a right to appropriate ground water.

1. Source from which water is withdrawn is Well

(Flowing well, pump well, infiltration trench, or tunnel)

2. Location is:

(Approximate distance and direction from nearest city or town)

and is more particularly described as follows:

(a) 322 feet N. 60°37' W. from the Southeast corner of the Wm. Pugh Donation L.C.

(Give distance and bearing to corner of section or other legal subdivision)

being within the NW 1/4 of the NW 1/4 of Sec. 1, Twp. 7 S, Rge. 3 W WM

(Smallest legal subdivision)

(N. or S.)

(E. or W.)

or (b) within limits of recorded platted property, town or city:

in Lot _____, Block _____ of _____

(Name of plat or addition)

County of _____

(If within city or town, give name)

3. Construction Work was begun on 1946; was completed on 1946

(Date)

(Date)

and the ground water claimed was first used for the purposes set out below on 1947

(Date)

since which time the water has been used during irrigation seasons

(Continuously or intermittently)

from 1947 to present

(Date)

(Date)

4. Quantity of water claimed and used is 12 gallons per minute; 5 acre feet per year.

5. Purpose or Purposes for which water is used Irrigation

(Domestic, irrigation, municipal, manufacturing, industrial, etc.)

6. Description of Well: Depth 59 feet. Type Drilled

(Dug or drilled)

diameter 6 inches. Elevation of ground at well site _____ feet, mean sea level.

(As near as known)

Depth to water table 20 feet.

7. Capacity of Well: 720 g.p.m. with 12 feet drawdown.

_____ g.p.m. with _____ feet drawdown.

Date of test _____

If Flowing Well: Measured discharge _____ g.p.m. on _____

(Date)


Shut-in pressure at ground surface _____ lbs. per sq. in. on _____

(Date)

Water is controlled by _____

(Cap, valve, etc.)

Township 7S Range 3W W.M.
North

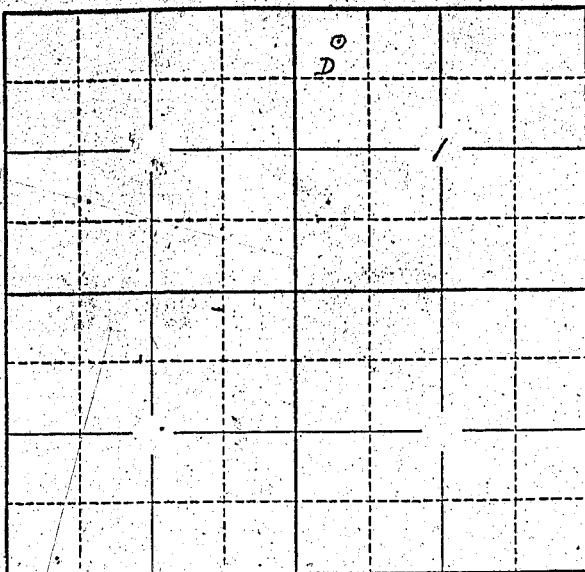

Locate well and acreage of irrigated land on plat.
Scale: 2" = 1 Mile.

STATE OF OREGON

County of Marion

} ss.

I, Robert F. Schroeder, being first duly sworn, do hereby certify that I have read the foregoing Registration Statement and that all of the items therein contained are true to the best of my knowledge and belief.

Robert F. Schroeder
(Signature of Registrant)

Subscribed and sworn to before me this 18th day of July, 1958.

My commission expires Sept. 8, 1960

Charles J. [Signature]
(Notary Public)

(SEAL)

CERTIFICATE OF REGISTRATION

STATE OF OREGON

County of Marion

} ss.

This is to certify that the foregoing Registration Statement was received in the office of the State Engineer on the 18th day of July, 1958, at 10⁰⁰ o'clock A. M. and has been duly recorded in said office in Book No. 10 of Registration Statements on page GR 2165

Witness my hand this 10th day of March

Luvinia A. Stanley
(State Engineer)

\$1500

By _____ (Deputy)

GR - 2165