

Registration Statement

OF CLAIMANT OF RIGHT TO APPROPRIATE GROUND WATER

TO THE STATE ENGINEER OF OREGON:

I, D. J. Nickerson
of Rt. 1 Box 877 Junction City Ore (Mailing address) County of Jamez
State of Oregon, do hereby make application for a certificate of registration as evidence of a right to appropriate ground water.

1. Source from which water is withdrawn is pump well #2
(Flowing well, pump well, infiltration trench, or tunnel)
2. Location is: 3 miles north Junction City Ore
(Approximate distance and direction from nearest city or town)

and is more particularly described as follows:

(a) 122.83 ft west S. from S. D. L. C. # 9 then 99.92 feet south then 302 ft west
(Give distance and bearing to corner of section or other legal subdivision)
being within SE 1/4 of SE 1/4 of Sec. 18, Twp. 15 S, Rge. 4 W W4
(Smallest legal subdivision) (N. or S.) (E. or W.)

or (b) within limits of recorded platted property, town or city: Junction City
in Lot 1, Block of James S. Owen Domain Land claim # 85
(Name of plat or addition)
Junction City County of Jamez
(If within city or town, give name)

3. Construction Work was begun on April 1953, was completed on April 1953
(Date) (Date)
and the ground water claimed was first used for the purposes set out below on April 1953
(Date)
since which time the water has been used continuously
(Continuously or intermittently)
from April 1953 to July 1958
(Date) (Date)

4. Quantity of water claimed and used is 75 gallons per minute; 10 acre feet per year.

5. Purpose or Purposes for which water is used irrigation & domestic
(Domestic, irrigation, municipal, manufacturing, industrial, etc.)

6. Description of Well: Depth 21 feet. Type dug
(Dug or drilled)
diameter 1 1/4 inches. Elevation of ground at well site about 150 feet, mean sea level.
(As near as known)
Depth to water table 6 ft feet.

7. Capacity of Well: 75 g.p.m. with 2 1/2 feet drawdown.
75 g.p.m. with 75 feet drawdown.


Date of test April 1953

If Flowing Well: Measured discharge 75 g.p.m. on April 1953
(Date)

Shut-in pressure at ground surface _____ lbs. per sq. in. on _____
(Date)

Water is controlled by _____
(Cap, valve, etc.)

Township 15S Range 4W, W.M.
North

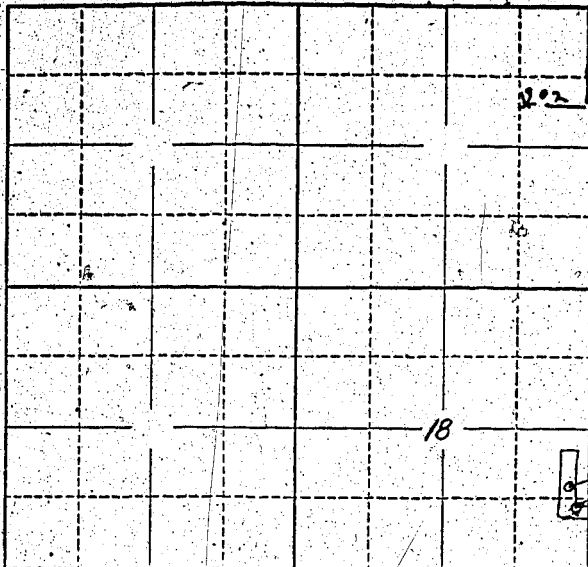

Locate well and acreage of irrigated land on plat.

Scale: 2" = 1 Mile

STATE OF OREGON

County of Marion

ss.

I, _____, being first duly sworn, do hereby certify that I have read the foregoing Registration Statement and that all of the items therein contained are true to the best of my knowledge and belief.

D. J. Nicholson
(Signature of Registrant)

Subscribed and sworn to before me this 18th day of July, 1958

My commission expires 12th June 1961 Wm. S. Bartholomew
(Notary Public)

(SEAL)

CERTIFICATE OF REGISTRATION

STATE OF OREGON

County of Marion

ss.

This is to certify that the foregoing Registration Statement was received in the office of the State Engineer on the 18th day of July, 1958, at 11:30 o'clock P. M. and has been duly recorded in said office in Book No. 10 of Registration Statements on page GR-2168

Witness my hand this 10th day of March, 1959

\$1500

Lewis A. Atkinson
(State Engineer)

By _____
(Deputy)

GR-2168