Registration No. GR-2278

Certificate No. GR 2171

Registration Statement

OF CLAIMANT OF RIGHT TO APPROPRIATE GROUND WATER

TO THE STATE ENGINEER OF OREGON:

I, NICK HOLOBOFF,

of 8095 N. RIVER RD SALEM, County of MARION
(Mailing address)

State of OREGON, do hereby make application for a certificate of registration as evidence of a right to appropriate ground water.

1. **Source** from which water is withdrawn is PUMP WELL
(Flowing well, pump well, infiltration trench, or tunnel)

2. **Location** is: 7 MILES NORTH OF SALEM ON RIVER RD.;
(Approximate distance and direction from nearest city or town)

and is more particularly described as follows:

(a) 650 feet west & 450 feet South from Center Section 24
(Give distance and bearing to corner of section or other legal subdivision)

being within N.E. 1/4 of S.W. 1/4 of Sec. 24, Twp. 6 S. (N. or S.), Rge. 3 W. (E. or W.)
(Smallest legal subdivision)

or (b) within limits of recorded platted property, town or city:

in Lot ....., Block ..... of .....
(Name of plat or addition)

..... County of MARION
(If within city or town, give name)

3. **Construction Work** was begun on JUNE I 1950 (Date); was completed on JUNE II 1950 (Date)

and the ground water claimed was first used for the purposes set out below on JUNE 18 1950 (Date),

since which time the water has been used INTERMITTENTLY
(Continuously or intermittently)

from JUNE 18 1950 (Date) to DATE (Date)

4. **Quantity** of water claimed and used is 250 gallons per minute; ..... acre feet per year.

5. **Purpose or Purposes** for which water is used AGRICULTURE CROPS IRRIGATION
(Domestic, irrigation, municipal, manufacturing, industrial, etc.)

6. **Description of Well:** Depth 110 feet. Type DRILLED (CABLE TOOLS)
(Dug or drilled)

diameter 8 inches. Elevation of ground at well site 181 feet, mean sea level.
(As near as known)

Depth to water table 35 feet.

7. **Capacity of Well:** 400 g.p.m. with 35 feet drawdown.

..... g.p.m. with ..... feet drawdown.

Date of test .....

If Flowing Well: Measured discharge ..... g.p.m. on .....
(Date)

Shut-in pressure at ground surface ..... lbs. per sq. in. on .....
(Date)

Water is controlled by .....
(Cap, valve, etc.)

8. **Casing:** (Give diameter, commercial specifications and depth below ground surface of each casing size.)

8 inch diameter 24.70 from Top to 110 feet

inch diameter from to feet

inch diameter from to feet

inch diameter from to feet

Describe and show depth of shoe, plug, adapter, liner or other details:

9. **Perforated Casings or Screens:**

PERFORATION SIZE ¼" WIDE 4" LONG & 5 ROWS TO FT. from 98 to 110
(Number per foot and size of perforations, or describe screen)

from to

from to

from to

10. **Log of Well:** (Describe each stratum or formation clearly, indicate if water bearing, and give thickness and depth as indicated.)

MATERIAL	Thickness (Feet)	Depth to Bottom (Feet)
TOP SOIL	0	3
YELLOW CLAY	3	35
YELLOW SAND	35	40
BLUE SHALE	40	90
BLACK SAND WITH WATER	90	95
SAND & GRAVEL WATER BERRING	95	100
WATER BERRING GRAVEL	100	110

GR 2171

If log of well is not available, give name and address of driller. .....

Emil O. Beier 7555 O'Neil Road Salem, Oregon

11. **Infiltration Trench:** Covered or open .....

Dimensions: Length ..... ft. Minimum depth ..... ft. Maximum depth ..... ft.

Bottom width ..... ft. Discharge ..... g.p.m. Date of test .....

12. **Tunnel:** Type of lining .....

Dimensions: .....
(Length, course, and cross sectional size)

Position of water bearing stratum with reference to portal of tunnel .....

Log of tunnel: (Preceding table for log of well may be used, if desired. Give footage from portal and character of materials, as pertinent.)

13. **Pumping Equipment:**

(a) Pump FAIRBANKS MORSE (Make, type and size) Capacity 300 g.p.m.

(b) Motor 15 HORSE TURBINE (Type and horsepower)

14. Location of area irrigated or to be irrigated, or place of use if for purposes other than irrigation.

Township North or South	Range E. or W. of Willamette Meridian	Section	Forty-acre Tract	Number Acres To Be Irrigated	Date of Reclamation
6-S	3-W	24	NW¼ of SE¼	5.0	1950
6-S	3-W	24	NE¼ of SW¼	23.0	"
				28.0	

15. If the ground water supply is supplemental to an existing water supply, identification of any application for a permit, permit, certificate or adjudicated right to appropriate water made or held by the registrant.

.....

.....

GR 2171

Township 6S Range 3W, W.M.

North

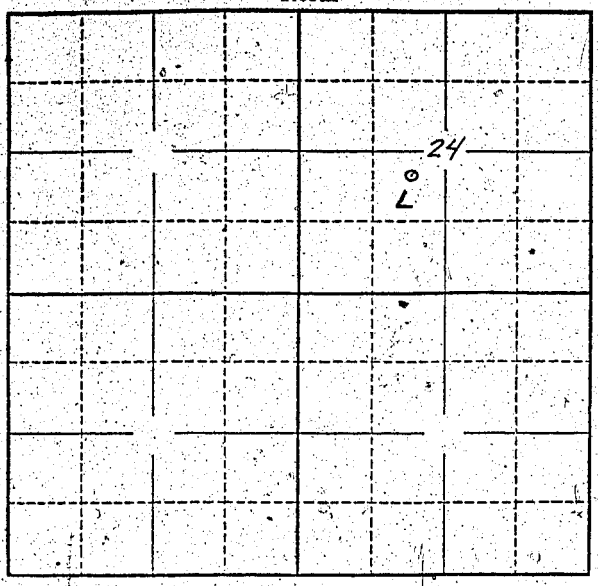

Locate well and acreage of irrigated land on plat.

Scale: 2" = 1 Mile

STATE OF OREGON
County of Marion } ss.

I, ..., being first duly sworn, do hereby certify that I have read the foregoing Registration Statement and that all of the items therein contained are true to the best of my knowledge and belief.

Irick Holoboff
(Signature of Registrant)

Subscribed and sworn to before me this 18th day of July, 1958.

My commission expires 12th June 1961

Wm. S. Bartholomew
(Notary Public)

(SEAL)

CERTIFICATE OF REGISTRATION

STATE OF OREGON
County of Marion } ss.

This is to certify that the foregoing Registration Statement was received in the office of the State Engineer on the 18 day of July, 1958, at 3:15 o'clock P. M. and has been duly recorded in said office in Book No. 10 of Registration Statements on page GR-2171

Witness my hand this 10th day of March, 1959

Lewis A. Stanley
(State Engineer)

By .....
(Deputy)

$15.00

GR-2171