

# Registration Statement

## OF CLAIMANT OF RIGHT TO APPROPRIATE GROUND WATER

TO THE STATE ENGINEER OF OREGON:

I, T. Jack Kundert

of 1210 Claggett Street, Salem  
(Mailing address)

County of Marion

State of Oregon, do hereby make application for a certificate of registration as evidence of a right to appropriate ground water.

1. Source from which water is withdrawn is Pump well  
(Flowing well, pump well, infiltration trench, or tunnel)

2. Location is: 5 miles North of Salem, Oregon  
(Approximate distance and direction from nearest city or town)

and is more particularly described as follows:

(a) 304.6' W. and 311.2' N. of the S.E. corner of S.E. 1/4 of S.W. 1/4  
(Give distance and bearing to corner of section or other legal subdivision)

being within S.E. 1/4 of S.W. 1/4 of Sec. 35, Twp. 6 S., Rge. 3 W.  
(Smallest legal subdivision) (N. or S.) (E. or W.)

or (b) within limits of recorded platted property, town or city:

in Lot \_\_\_\_\_, Block \_\_\_\_\_ of \_\_\_\_\_  
(Name of plat or addition)

(If within city or town, give name) County of \_\_\_\_\_

3. Construction Work was begun on May 7, 1950; was completed on May 7, 1950  
(Date) (Date)

and the ground water claimed was first used for the purposes set out below on May 7, 1950  
(Date)

since which time the water has been used continuously  
(Continuously or Intermittently)

from May 7, 1950 to July, 1958  
(Date) (Date)

4. Quantity of water claimed and used is 25 gallons per minute; 6 acre feet per year.

5. Purpose or Purposes for which water is used, Irrigation **RK**  
(Domestic, irrigation, municipal, manufacturing, industrial, etc.)

6. Description of Well: Depth 32 feet. Type Drilled  
(Dug or drilled)

diameter 6 inches. Elevation of ground at well site \_\_\_\_\_ feet, mean sea level.  
(As near as known)

Depth to water table 14 feet.

7. Capacity of Well: 40 g.p.m. with 6 feet drawdown.

\_\_\_\_\_ g.p.m. with \_\_\_\_\_ feet drawdown.

Date of test May 7, 1950

If Flowing Well: Measured discharge \_\_\_\_\_ g.p.m. on \_\_\_\_\_  
(Date)


Shut-in pressure at ground surface \_\_\_\_\_ lbs. per sq. in. on \_\_\_\_\_  
(Date)

Water is controlled by \_\_\_\_\_  
(Cap, valve, etc.)





Township 6S Range 3W, W.M.  
North

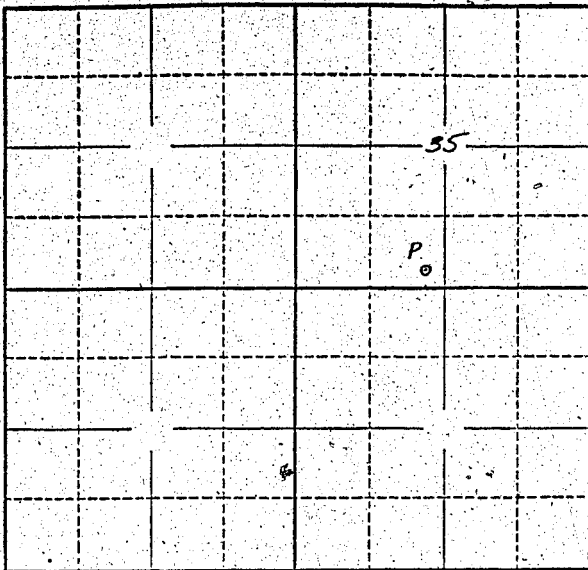

Locate well and acreage of irrigated land on plat.  
Scale: 2" = 1 Mile

STATE OF OREGON

County of Marion } ss.

I, Walter J. ..., being first duly sworn, do hereby certify that I have read the foregoing Registration Statement and that all of the items therein contained are true to the best of my knowledge and belief.

Walter J. ...  
(Signature of Registrant)

Subscribed and sworn to before me this 16 day of July, 1958.

My commission expires Dec 5<sup>th</sup> 1959 William J. ...  
(Notary Public)

(SEAL)

**CERTIFICATE OF REGISTRATION**

STATE OF OREGON

County of Marion } ss.

This is to certify that the foregoing Registration Statement was received in the office of the State Engineer on the 18th day of July, 1958, at 3:30 o'clock P.M. and has been duly recorded in said office in Book No. 10 of Registration Statements on page GR-2173

Witness my hand this 10<sup>th</sup> day of March, 1959.

Luvia A. Stanley  
(State Engineer)

By \_\_\_\_\_  
(Deputy)

8/5-00

GR -2173