

Registration Statement

OF CLAIMANT OF RIGHT TO APPROPRIATE GROUND WATER

TO THE STATE ENGINEER OF OREGON:

I, ANNEN BROS
 of RT 1 13th 92 MT. Angel County of MARION
(Mailing address)
 State of OREGON do hereby make application for a certificate of registration as evidence of a right to appropriate ground water.

- Source from which water is withdrawn is flowing well
(Flowing well, pump well, infiltration trench, or tunnel)
- Location is: 1 mile West of Monitor
(Approximate distance and direction from nearest city or town)

and is more particularly described as follows:

(a) 5 ch. N. and 3 ch. W from the SE corner of Sec 26
(Give distance and bearing to corner of section or other legal subdivision)
 being within SW 1/4 S 9 1/4 of Sec. 26, Twp. 53, Rge. 1 W
(Smallest legal subdivision) (N. or S.) (E. or W.)

or (b) within limits of recorded platted property, town or city:
 in Lot _____, Block _____ of _____
(Name of plat or addition)
 County of _____
(If within city or town, give name)

3. Construction Work was begun on 2-4-53; was completed on 4-14-53
(Date) (Date)
 and the ground water claimed was first used for the purposes set out below on 4-53
(Date)
 since which time the water has been used During Irrigation Season
(Continuously or intermittently)
 from 1953 to Present
(Date) (Date)

4. Quantity of water claimed and used is 280 gallons per minute; 1.724 acre feet per year.

5. Purpose or Purposes for which water is used irrigation
(Domestic, irrigation, municipal, manufacturing, industrial, etc.)

6. Description of Well: Depth 188 feet. Type drilled
(Dug or drilled)
 diameter 10 inches. Elevation of ground at well site _____ feet, mean sea level.
(As near as known)
 Depth to water table 59 feet.

7. Capacity of Well: 330 g.p.m. with 7.5 feet drawdown.
 _____ g.p.m. with _____ feet drawdown.

Date of test 4-15-53
 If Flowing Well: Measured discharge _____ g.p.m. on _____
(Date)
 Shut-in pressure at ground surface _____ lbs. per sq. in. on _____
(Date)
 Water is controlled by _____
(Cap. valve, etc.)

8. Casing: (Give diameter, commercial specifications and depth below ground surface of each casing size.)

10 inch diameter from Top to 188' feet
 inch diameter from to feet
 inch diameter from to feet
 inch diameter from to feet

Describe and show depth of shoe, plug, adapter, liner or other details:


9. Perforated Casings or Screens:

3/8 x 1/2 slots 1 from 45' to 55'
 (Number per foot and size of perforations, or describe screen) 4 from 65' to 85'
 3 from 110' to 115'
 3 from 155' to 185'

10. Log of Well: (Describe each stratum or formation clearly, indicate if water bearing, and give thickness and depth as indicated.)

MATERIAL	Thickness (Feet)	Depth to Bottom (Feet)
	0	to 8
	8	32
Topsoil + Brown Clay	8	8
Brown silt	24	32
Cement Gravel (Brown)	24	56
Blue Clay	12	68
Gravel & sand (water)	16	84
Clay Dark Blue	26	110
Pea gravel + clay	3	113
Blue clay	42	155
Sand	5	160
Clay Blue	20	180
Sand light blue	5	185
Light Blue Clay	3	188

Township 5 S Range 1 W, W.M.
North

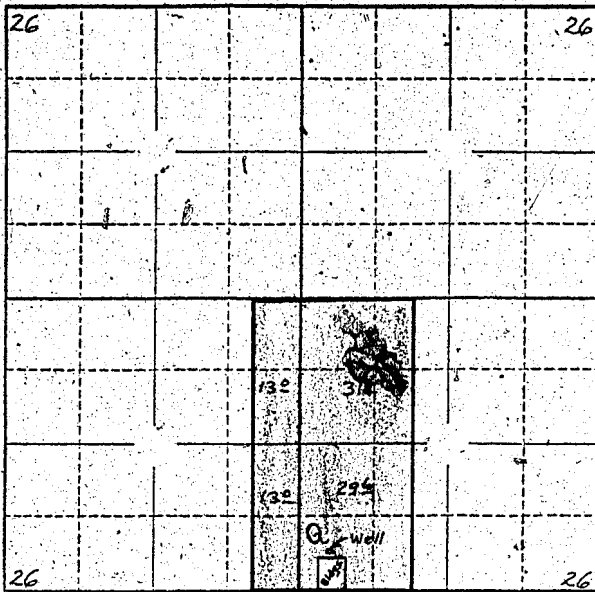

Locate well and acreage of irrigated land on plat.
Scale: $\frac{1}{4}$ " = 1 Mile

STATE OF OREGON

County of Marion } ss.

I, _____, being first duly sworn, do hereby certify that I have read the foregoing Registration Statement and that all of the items therein contained are true to the best of my knowledge and belief.

Victor J. Owen
(Signature of Registrant)

Subscribed and sworn to before me this 18th day of July, 1958

My commission expires 12th June 1961 Wm. S. Bartholomew
(Notary Public)

(SEAL)

CERTIFICATE OF REGISTRATION

STATE OF OREGON }
County of Marion } ss.

This is to certify that the foregoing Registration Statement was received in the office of the State Engineer on the 18th day of July, 1958, at 4:00 o'clock P.M. and has been duly recorded in said office in Book No. 10 of Registration Statements on page GR-3820

Witness my hand this 4th day of December, 1959

Lewis A. Stanley
(State Engineer)

By _____
(Deputy)

\$ 23.55

GR 3820