

Registration Statement

OF CLAIMANT OF RIGHT TO APPROPRIATE GROUND WATER

TO THE STATE ENGINEER OF OREGON:

I, Thomas and Carol G. Wilkinson
of Rt. 2, Box 292 C, Albany, County of Linn
(Mailing address)

State of Oregon, do hereby make application for a certificate of registration as evidence of a right to appropriate ground water.

1. Source from which water is withdrawn is Pump Well
(Flowing well, pump well, infiltration trench, or tunnel)

2. Location is: 7 miles North of Albany, Oregon
(Approximate distance and direction from nearest city or town)

and is more particularly described as follows:

(a) S $^{\circ}$ 85 $^{\circ}$ 40' W. 26.25 chains from SW corner of DLC 69
(Give distance and bearing to corner of section or other legal subdivision)

being within NW 1_4 of SE 4 , of Sec. 18, Twp. 10 S., Rge. 3 W.
(Smallest legal subdivision) (N. or S.) (E. or W.)

or (b) within limits of recorded platted property, town or city:

in Lot _____, Block _____ of _____
(Name of plat or addition)
County of Linn
(If community or town, give name)

3. Construction Work was begun on June 10, 1955; was completed on June 20, 1955.
(Date) (Date)

and the ground water claimed was first used for the purposes set out below on June 25, 1955.
(Date)

since which time the water has been used continuously
(Continuously or intermittently)

from June 25, 1955 to present time
(Date) (Date)

4. Quantity of water claimed and used is 250 gallons per minute; 115.8 acre feet per year.

5. Purpose or Purposes for which water is used Irrigation
(Domestic, irrigation, municipal, manufacturing, industrial, etc.)

6. Description of Well: Depth 37 feet. Type Drilled
(Dug or drilled)
diameter 8 inches. Elevation of ground at well site 195 feet, mean-sea level.
(As near as known)

Depth to water table 23 feet.

7. Capacity of Well: 250 g.p.m. with 2 feet drawdown.
g.p.m. with feet drawdown.

Date of test June 25, 1955

If Flowing Well: Measured discharge g.p.m. on
(Date)

Shut-in pressure at ground surface lbs. per sq. in. on
(Date)

Water is controlled by
(Cap. valve, etc.)

8. Casing: (Give diameter, commercial specifications and depth below ground surface of each casing size.)

8 inch diameter steel casing from 0 to 37 feet
inch diameter from to feet
inch diameter from to feet
inch diameter from to feet

Describe and show depth of shoe, plug, adapter, liner or other details: _____

9. Perforated Casings or Screens:

Slot perforations

(Number per foot and size of perforations, or describe except)

from 27 to 37

from to

from to

from to

10. Log of Well: (Describe each stratum or formation clearly, indicate if water bearing, and give thickness and depth as indicated.)

11. Infiltration Trench: Covered or open

Dimensions: Length _____ ft. Minimum depth _____ ft. Maximum depth _____ ft.

Bottom width _____ ft. Discharge _____ g.p.m. Date of test _____

12. Tunnel: Type of lining

Dimensions: _____ (Length, course, and cross sectional size)

Position of water bearing stratum with reference to portal of tunnel _____

Log of tunnel: (Preceding table for log of well may be used, if desired. Give footage from portal and character of materials, as pertinent.)

13. Pumping Equipment:

(a) Pump	Berkeley 2" centrifugal	Capacity	250	g.p.m.
(Make, type and size)				
(b) Motor	15 H. P. Electric	(Type and horsepower)		

14. Location of area irrigated or to be irrigated, or place of use if for purposes other than irrigation.

Township North or South	Range E. or W. of Willamette Meridian	Section	Forty-acre Tract	Number Acres To Be Irrigated	Date of Reclamation
10 S	3 W	17	SW ¹ / ₄ of NW ¹ / ₄	4.8	June 25, 1955
10 S	3 W	17	NW ¹ / ₄ of SW ¹ / ₄	26.4	" "
10 S	3 W	18	SE ¹ / ₄ of NE ¹ / ₄	1.1	" "
10 S	3 W	18	NE ¹ / ₄ of SE ¹ / ₄	6.3	" "
				38.6	


242-769 Wilkinson (Hanslovan)

Beginning at the Southwest corner of the D.L.C. of John Fenn, Not. No. 1673 and Claim No. 69 in T. 10 S., R. 3 W. of the Will. Mer. in Linn County, Oregon; and running thence N.88°30'E. 20.81 chains; thence N.1°45'W. 19.23 chains; thence S.88°30'W. 20.81 chains to the West line of said D.L.C.; thence S.1°45'E. along the Westerly boundary line of said D.L.C. 19.23 chains to the place of beginning, containing 40 acres, more or less.

15. If the ground water supply is supplemental to an existing water supply, identification of any application for a permit, permit, certificate or adjudicated right to appropriate water made or held by the registrant.

Township 10 S Range 3 W., W.M.

North

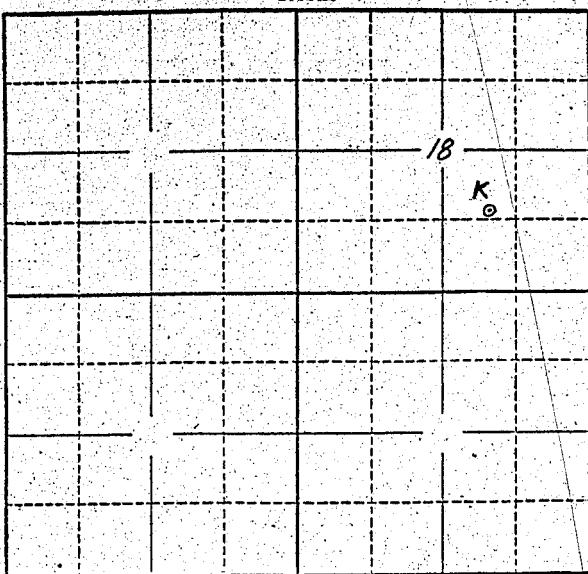

Locate well and acreage of irrigated land on plat.

Scale: 2" — 1 Mile

STATE OF OREGON

County of LINN

{ ss.

I, Thomas and Carol G. Wilkinson, being first duly sworn, do hereby certify that I have read the foregoing Registration Statement and that all of the items therein contained are true to the best of my knowledge and belief.

Carol G. Wilkinson
Thomas Wilkinson

(Signature of Registrant)

Subscribed and sworn to before me this 16th day of July, 1958.

My commission expires April 3, 1960

(SEAL)

John D. Deeth
NOTARY PUBLIC
My Commission Expires April 3, 1960

CERTIFICATE OF REGISTRATION

STATE OF OREGON

County of Marion

{ ss.

This is to certify that the foregoing Registration Statement was received in the office of the State Engineer on the 18th day of July, 1958, at 8:00 o'clock A.M. and has been duly recorded in said office in Book No. 10 of Registration Statements on page GR-2176.

Witness my hand this 10th day of March, 1959.

Elmer A. Stanley
(State Engineer)

16-35

By

(Deputy)

GR 2176