

RECEIVED
JUL 17 1953
STATE ENGINEER
SALEM, OREGON

Registration No. GR - 2284
Certificate No. GR - 2177

Registration Statement

OF CLAIMANT OF RIGHT TO APPROPRIATE GROUND WATER

TO THE STATE ENGINEER OF OREGON:

I, James S. Ruby

of Route 3, Box 17, Scio
(Mailing address)

County of Linn

State of Oregon, do hereby make application for a certificate of registration as evidence of a right to appropriate ground water.

1. Source from which water is withdrawn is pump well
(Flowing well, pump well, infiltration trench, or tunnel)

2. Location is: 2 1/2 miles S.W. of Scio, Oregon
(Approximate distance and direction from nearest city or town)

and is more particularly described as follows:

(a) 3,036' S. and 1,518' W. of NE corner of S. 24, T. 10S., R. 2 W.
(Give distance and bearing to corner of section or other legal subdivision)

being within NW 1/4 of SE 1/4 of Sec. 24, Twp. 10S, Rge. 2W
(Smallest legal subdivision) (N. or S.) (E. or W.)

or (b) within limits of recorded platted property, town or city:

in Lot _____, Block _____ of _____
(Name of plat or addition)

County of Linn

(If within city or town, give name)

3. Construction Work was begun on August 1952; was completed on August 1952
(Date) (Date)

and the ground water claimed was first used for the purposes set out below on May 1953
(Date)

since which time the water has been used continuously
(Continuously or intermittently)

from May 1953 to present time
(Date) (Date)

4. Quantity of water claimed and used is 70 gallons per minute; 75.0 acre feet per year.

5. Purpose or Purposes for which water is used Irrigation

(Domestic, irrigation, municipal, manufacturing, industrial, etc.)

6. Description of Well: Depth 257 feet. Type drilled

(Dug or drilled)

diameter 8 inches. Elevation of ground at well site 400 feet, mean sea level.

(As near as known)

Depth to water table 250 feet.

7. Capacity of Well: 60 g.p.m. with 100 feet drawdown.

_____ g.p.m. with _____ feet drawdown.

Date of test January 1953

If Flowing Well: Measured discharge _____ g.p.m. on _____

(Date)

Shut-in pressure at ground surface _____ lbs. per sq. in. on _____

(Date)

Water is controlled by _____

(Cap, valve, etc.)

8. Casing: (Give diameter, commercial specifications and depth below ground surface of each casing size.)

8 inch diameter Steel pipe from 0 to 150 feet
..... inch diameter from to feet
..... inch diameter from to feet
..... inch diameter from to feet

Describe and show depth of shoe, plug, adapter, liner or other details:
.....
.....
.....

9. Perforated Casings or Screens:

None from to
(Number per foot and size of perforations, or describe screen)
..... from to
..... from to
..... from to

10. Log of Well: (Describe each stratum or formation clearly, indicate if water bearing, and give thickness and depth as indicated.)

MATERIAL	Thickness (Feet)	Depth to Bottom (Feet)
None available		

If log of well is not available, give name and address of driller, Mr. Rucker, Lebanon, Oregon

11. Infiltration Trench: Covered or open

Dimensions: Length ft. Minimum depth ft. Maximum depth ft.

Bottom width ft. Discharge g.p.m. Date of test

12. Tunnel: Type of lining

Dimensions:
(Length, course, and cross sectional size)

Position of water bearing stratum with reference to portal of tunnel

Log of tunnel: (Preceding table for log of well may be used, if desired. Give footage from portal and character of materials, as pertinent.)

13. Pumping Equipment:

(a) Pump Fairbank - Morse - Turbine - 7 stages Capacity 100 g.p.m.
(Make, type and size)


(b) Motor Electric - 10 H.P.
(Type and horsepower)

14. Location of area irrigated or to be irrigated, or place of use if for purposes other than irrigation.

Township North or South	Range E. or W. of Willamette Meridian	Section	Forty-acre Tract	Number Acres To Be Irrigated	Date of Reclamation
10 S	2 W	24	NW $\frac{1}{4}$ of SE $\frac{1}{4}$	16.8	May 1953
10 S	2 W	24	NE $\frac{1}{4}$ of SE $\frac{1}{4}$	6.2	May 1953
10 S	2 W	24	SW $\frac{1}{4}$ of SE $\frac{1}{4}$	2.0	May 1953
				A 25.0	

15. If the ground water supply is supplemental to an existing water supply, identification of any application for a permit, permit, certificate or adjudicated right to appropriate water made or held by the registrant.

Township 10 S. Range 2 W., W.M.
North

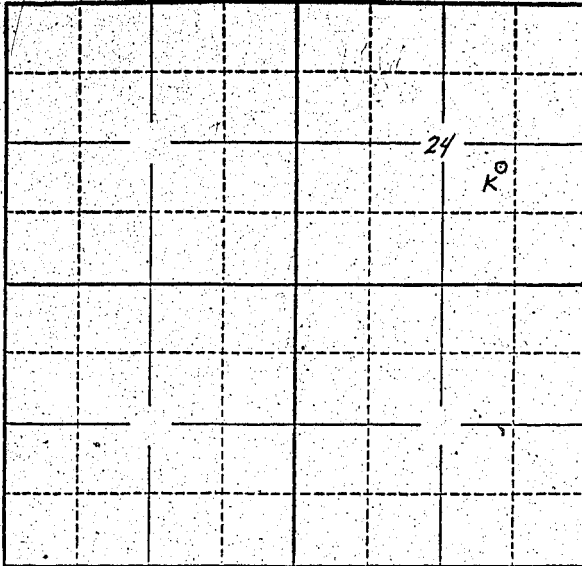

Locate well and acreage of irrigated land on plat.
Scale: 2" = 1 Mile

STATE OF OREGON

County of Linn } ss.

I, James S. Ruby, being first duly sworn, do hereby certify that I have read the foregoing Registration Statement and that all of the items therein contained are true to the best of my knowledge and belief.

James S. Ruby
(Signature of Registrant)

Subscribed and sworn to before me this 15 day of July, 1958.

My commission expires 12/4/59
(Notary Public)

(SEAL)

CERTIFICATE OF REGISTRATION

STATE OF OREGON } ss.
County of Marion

This is to certify that the foregoing Registration Statement was received in the office of the State Engineer on the 18th day of July, 1958, at 8:00 o'clock A. M. and has been duly recorded in said office in Book No. 10 of Registration Statements on page GR 2177.

Witness my hand this 10th day of March, 1959

Elmer A. Stanley
(State Engineer)

By _____
(Deputy)

GR - 2177

4/5-02