

Registration No. GR 2286  
Certificate No. GR 2179

# Registration Statement

## OF CLAIMANT OF RIGHT TO APPROPRIATE GROUND WATER

TO THE STATE ENGINEER OF OREGON:

I, M. C. Case  
of Route 2, Box 393, Albany County of Linn  
(Mailing address)  
State of Oregon do hereby make application for a certificate of registration as evidence of a right to appropriate ground water.

1. Source from which water is withdrawn is Pump well No. 11  
(Flowing well, pump well, infiltration trench, or tunnel)
2. Location is: 4 miles West of Jefferson, Oregon  
(Approximate distance and direction from nearest city or town)

and is more particularly described as follows:

(a) N. 61° 30' W. 41 chains from SE corner of NE 1/4 of S. 8, T. 10 S., R. 3 W.  
(Give distance and bearing to corner of section or other legal subdivision)  
being within SW 1/4 of NE 1/4 of Sec. 8, Twp. 10 S, Rge. 3 W  
(Smallest legal subdivision) (N. or S.) (E. or W.)

or (b) within limits of recorded platted property, town or city: \_\_\_\_\_  
in Lot \_\_\_\_\_, Block \_\_\_\_\_ of \_\_\_\_\_  
(Name of plat or addition)  
County of Linn  
(If within city or town, give name)

3. Construction Work was begun on 1946; was completed on 1946  
(Date) (Date)

and the ground water claimed was first used for the purposes set out below on 1946  
(Date)  
since which time the water has been used continuously  
(Continuously or intermittently)  
from 1946 to present time  
(Date) (Date)

4. Quantity of water claimed and used is 200 gallons per minute; 125 5/10 acre feet per year.

5. Purpose or Purposes for which water is used Irrigation  
(Domestic, irrigation, municipal, manufacturing, industrial, etc.)

6. Description of Well: Depth 22 feet. Type Drilled  
(Dug or drilled)  
diameter 8 inches. Elevation of ground at well site 190 feet, mean sea level.  
(As near as known)  
Depth to water table 7 feet.


7. Capacity of Well: 400 g.p.m. with \_\_\_\_\_ feet drawdown.  
\_\_\_\_\_ g.p.m. with \_\_\_\_\_ feet drawdown.

Date of test Estimated - not tested  
If Flowing Well: Measured discharge \_\_\_\_\_ g.p.m. on \_\_\_\_\_  
(Date)  
Shut-in pressure at ground surface \_\_\_\_\_ lbs. per sq. in. on \_\_\_\_\_  
(Date)  
Water is controlled by \_\_\_\_\_  
(Cap, valve, etc.)





Township 10 S Range 3 W, W.M.  
North

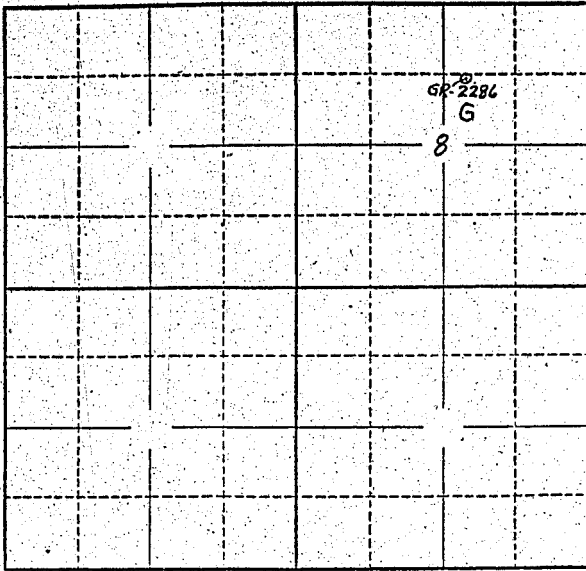

Locate well and acreage of irrigated land on plat.  
Scale: 2" = 1 Mile

STATE OF OREGON }  
County of Marion } ss.

I, M. C. Case, being first duly sworn, do hereby certify that I have read the foregoing Registration Statement and that all of the items therein contained are true to the best of my knowledge and belief.

M. C. Case  
(Signature of Registrant)

Subscribed and sworn to before me this 15 day of July, 1958

My commission expires NOTARY PUBLIC FOR OREGON  
My Commission Expires April 19, 1963.

Frank B. [Signature]  
(Notary Public)

(SEAL)

**CERTIFICATE OF REGISTRATION**

STATE OF OREGON }  
County of Marion } ss.

This is to certify that the foregoing Registration Statement was received in the office of the State Engineer on the 18<sup>th</sup> day of July, 1958, at 8:00 o'clock A. M. and has been duly recorded in said office in Book No. 10 of Registration Statements on page GR-2179.

Witness my hand this 10<sup>th</sup> day of March, 1959

Clara A. Stanley  
(State Engineer)

\$15.00

By \_\_\_\_\_  
(Deputy)

GR - 2179