

RECEIVED
JUL 14 1952
STATE ENGINEER
SALEM, OREGON

Registration No. GR-2292
Certificate No. GR-2187

Registration Statement

OF CLAIMANT OF RIGHT TO APPROPRIATE GROUND WATER

TO THE STATE ENGINEER OF OREGON:

I, Frank M. and Josephine B. Shores

of Rt. 2, Box 243 B, Lebanon

(Mailing address)

County of Linn

State of Oregon

do hereby make application for a certificate of registration as evidence of a right to appropriate ground water.

1. Source from which water is withdrawn is pump well

(Flowing well, pump well, infiltration trench, or tunnel)

2. Location is: 5 miles north of Lebanon, Oregon

(Approximate distance and direction from nearest city or town)

and is more particularly described as follows:

(a) 1370' N. and 2270' E. of NW corner DIC 57

(Give distance and bearing to corner of section or other legal subdivision)

being within NE¹ of NW¹

(Smallest legal subdivision)

of Sec. 26

Twp. 11 S

Rge. 2 W

(N. or S.)

(E. or W.)

or (b) within limits of recorded platted property, town or city:

in Lot _____, Block _____

of _____

(Name of plat or addition)

County of Linn

(If within city or town, give name)

3. Construction Work was begun on 1952

(Date)

; was completed on 1952

(Date)

and the ground water claimed was first used for the purposes set out below on 1952

(Date)

since which time the water has been used continuously

(Continuously or intermittently)

from 1952

(Date)

to present time

(Date)

4. Quantity of water claimed and used is 84 gallons per minute; 15.0 acre feet per year.

5. Purpose or Purposes for which water is used Irrigation

(Domestic, irrigation, municipal, manufacturing, industrial, etc.)

6. Description of Well: Depth 15 feet. Type Dug

(Dug or drilled)

diameter 3' X 3' inches.

Elevation of ground at well site 290

(As near as known)

feet, mean sea level.

Depth to water table 11 feet.

7. Capacity of Well: _____ g.p.m. with _____ feet drawdown.

_____ g.p.m. with _____ feet drawdown.

Date of test Not tested

If Flowing Well: Measured discharge _____ g.p.m. on _____

(Date)


Shut-in pressure at ground surface _____ lbs. per sq. in. on _____

(Date)

Water is controlled by _____

(Cap, valve, etc.)

Township 11 S Range 2 W, W.M.
North

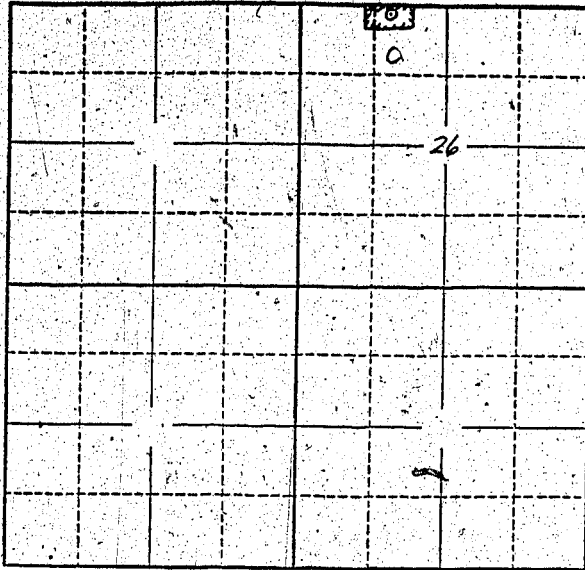

Locate well and acreage of irrigated land on plat.
Scale: 2" = 1 Mile

STATE OF OREGON

County of LINN

} ss.

I, Frank M. and Josephine B. Shores, being first duly sworn, do hereby certify that I have read the foregoing Registration Statement and that all of the items therein contained are true to the best of my knowledge and belief.

Frank M. Shores
Josephine B. Shores
(Signature of Registrant)

Subscribed and sworn to before me this 16th day of July, 1958.

My commission expires September 21, 1960.

Walter Hasel
(Notary Public) for Oregon.

(SEAL)

CERTIFICATE OF REGISTRATION

STATE OF OREGON

County of Marion

} ss.

This is to certify that the foregoing Registration Statement was received in the office of the State Engineer on the 18th day of July, 1958, at 8:00 o'clock A. M. and has been duly recorded in said office in Book No. 10 of Registration Statements on page GR-2187

Witness my hand this 10th day of March, 1959.

Lewis A. Stanley
(State Engineer)

By _____
(Deputy)

GR - 2187

#1500