

RECEIVED  
SEP 2 1955

RECEIVED  
OCT 4 1955

STATE ENGINEER  
SALEM, OREGON

STATE ENGINEER  
SALEM, OREGON

# Registration Statement

GR-23  
REGISTRATION NO. \_\_\_\_\_  
CERTIFICATE NO. GR-19

## OF CLAIMANT OF RIGHT TO APPROPRIATE GROUND WATER

(Under Chapter 708, Oregon Laws 1955.)

TO THE STATE ENGINEER OF OREGON:

I, Willard Ball  
of Central Point County of Jackson

State of Oregon, do hereby make application for a certificate of registration as evidence of a right to appropriate ground water.

- Source from which water is withdrawn is Sump  
(Flowing well, pump well, infiltration trench, or tunnel)
- Location is: 1/4 mile North East of Central Point, Oregon  
(Approximate distance and direction from nearest city or town)

and is more particularly described as follows:

(a) \_\_\_\_\_  
(Give distance and bearing to corner of section or other legal subdivision)  
being within 5 1/2 of NW 1/4 of Sec. 2, Twp. 37, Rge. 2 W  
(Smallest legal subdivision) (N. or S.) (E. or W.)

or (b) within limits of recorded platted property, town or city: \_\_\_\_\_  
in Lot \_\_\_\_\_, Block \_\_\_\_\_ of \_\_\_\_\_  
(Name of plat or addition)

County of \_\_\_\_\_  
(If within city or town, give name)

- Construction Work was begun on Aug 24, 1946; was completed on Aug 27, 1946  
(Date) (Date)  
and the ground water claimed was first used for the purposes set out below on April 1947  
(Date)  
since which time the water has been used continuously in season  
(Continuously or intermittently)  
from April 1947 to Present time  
(Date) (Date)

4. Quantity of water claimed and used is 120 gallons per minute; \_\_\_\_\_ acre feet per year.

5. Purpose or Purposes for which water is used PASTURE  
(Domestic, irrigation, municipal, manufacturing, industrial, etc.)

6. Description of Well: Depth 14 feet. Type 6.0" x 3.5" Pump (Dug)  
(Dug or drilled)  
diameter 3 inches. Elevation of ground at well site 1260' feet, mean sea level.  
(As near as known)  
Depth to water table 5' feet.

7. Capacity of Well: \_\_\_\_\_ g.p.m. with \_\_\_\_\_ feet drawdown.  
\_\_\_\_\_ g.p.m. with \_\_\_\_\_ feet drawdown.

Date of test \_\_\_\_\_

If Flowing Well: Measured discharge \_\_\_\_\_ g.p.m. on \_\_\_\_\_  
(Date)


Shut-in pressure at ground surface \_\_\_\_\_ lbs. per sq. in. on \_\_\_\_\_  
(Date)

Water is controlled by \_\_\_\_\_  
(Cap, valve, etc.)





Township 37s Range 2w W.M.  
North

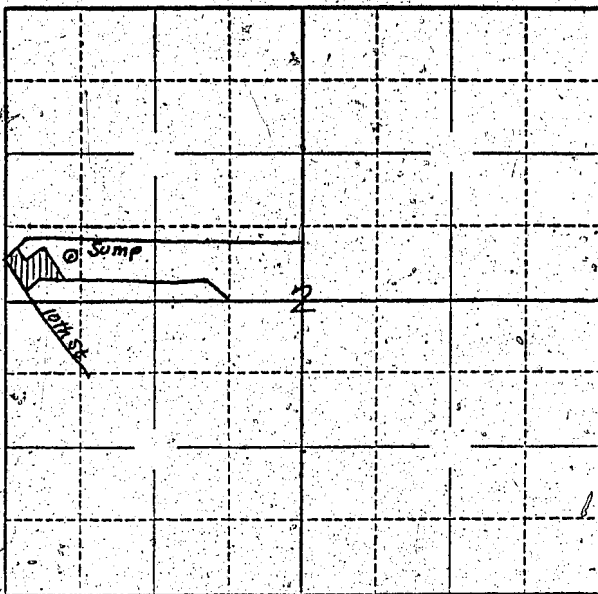

Locate well and acreage of irrigated land on plat.

Scale:  $\frac{2''}{4''} = 1 \text{ Mile}$

STATE OF OREGON

County of Jackson } ss.

I, Willard Ball, being first duly sworn, do hereby certify that I have read the foregoing Registration Statement and that all of the items therein contained are true to the best of my knowledge and belief.

Willard Ball  
(Signature of Registrant)

Subscribed and sworn to before me this 22 day of Sept, 1955

My commission expires \_\_\_\_\_

Marion J. Japic  
(Notary Public)

(SEAL)

MY COMMISSION EXPIRES JULY, 29, 195

**CERTIFICATE OF REGISTRATION**

STATE OF OREGON

County of Marion } ss.

This is to certify that the foregoing Registration Statement was received in the office of the State Engineer on the 4th day of October, 1955, at 1:00 o'clock P. M. and has been duly recorded in said office in Book No. 1 of Registration Statements on page 19.

Construction shall be completed by 15 \_\_\_\_\_, 1955, and the water 15 completely applied to beneficial use by \_\_\_\_\_, 1955.

Witness my hand this 24th day of February, 1956.  
Lewis A. Stanley  
(State Engineer)

By \_\_\_\_\_ (Deputy)