RECEIVED
AUG 1 1956
STATE ENGINEER
SALEM, OREGON

REGISTRATION NO. GR-230

Registration Statement

CERTIFICATE NO. GR-211

OF CLAIMANT OF RIGHT TO APPROPRIATE GROUND WATER

(Under Chapter 708, Oregon Laws 1955.)

TO THE STATE ENGINEER OF OREGON:

I, William H. Benkston & Alberta M. Benkston,

of Aumsville County of Marion

State of Oregon, do hereby make application for a certificate of registration as evidence of a right to appropriate ground water.

1. **Source** from which water is withdrawn is Infiltration
(Flowing well, pump well, infiltration trench, or tunnel)

2. **Location** is: One mile east of Aumsville
(Approximate distance and direction from nearest city or town)

and is more particularly described as follows:

(a) North 23° 17' West 58.26 cheins from S. W. cor. A. Davis D. L. C.
(Give distance and bearing to corner of section or other legal subdivision)

being within SE 4 of NE4 of Sec. 31, Twp. 9 S. (N. or S.), Rge. 1 W. (E. or W.)
(Smallest legal subdivision)

or (b) within limits of recorded platted property, town or city;

in Lot ..., Block ... of ...
(Name of plat or addition)

... County of ...
(If within city or town, give name)

3. **Construction Work** was begun on July 1947 (Date); was completed on July 1947 (Date)

and the ground water claimed was first used for the purposes set out below on July 1947 (Date),

since which time the water has been used continously
(Continuously or intermittently)

from 1947 (Date) to June, 1956 (Date)

4. **Quantity** of water claimed and used is 112 gallons per minute; 30 acre feet per year.

5. **Purpose or Purposes** for which water is used Irrigation
(Domestic, irrigation, municipal, manufacturing, industrial, etc.)

6. **Description of Well:** Depth 120 feet. Type Excavated by power shovel
(Dug or drilled)

diameter 30 x 40 inches. Elevation of ground at well site 378 (As near as known) feet, mean sea level.

Depth to water table 6 feet.

7. **Capacity of Well:** 112 g.p.m. with 2 feet drawdown in 6 hours

... g.p.m. with ... feet drawdown.

Date of test various

If Flowing Well: Measured discharge ... g.p.m. on ... (Date)

Shut-in pressure at ground surface ... lbs. per sq. in. on ... (Date)

Water is controlled by ... (Cap, valve, etc.)

8. **Casing:** (Give diameter, commercial specifications and depth below ground surface of each casing size.)

_____ inch diameter No record from _____ to _____ feet

_____ inch diameter _____ from _____ to _____ feet

_____ inch diameter _____ from _____ to _____ feet

_____ inch diameter _____ from _____ to _____ feet

Describe and show depth of shoe, plug, adapter, liner or other details: _____

9. **Perforated Casings or Screens:**

No record from _____ to _____
(Number per foot and size of perforations, or describe screen)

_____ from _____ to _____

_____ from _____ to _____

_____ from _____ to _____

10. **Log of Well:** (Describe each stratum or formation clearly, indicate if water bearing, and give thickness and depth as indicated.)

MATERIAL	Thickness (Feet)	Depth to Bottom (Feet)
No record		

GR-211 A

If log of well is not available, give name and address of driller. .....

11. **Infiltration Trench:** Covered or open open

Dimensions: Length 30 x 40 ft. Minimum depth ..... ft. Maximum depth 12 + ft.
approximately
Bottom width 20 x 20 ft. Discharge ? g.p.m. Date of test .....

12. **Tunnel:** Type of lining .....

Dimensions: ..... (Length, course, and cross sectional size)

Position of water bearing stratum with reference to portal of tunnel .....

Log of tunnel: (Preceding table for log of well may be used, if desired. Give footage from portal and character of materials, as pertinent.)

13. **Pumping Equipment:**

(a) Pump Pacific centrifugal (Make, type and size) Capacity 112 + g.p.m.

(b) Motor Waid 12 H P. gas (Type and horsepower)

14. Location of area irrigated or to be irrigated, or place of use if for purposes other than irrigation.

Township North or South	Range E. or W. of Willamette Meridian	Section	Forty-acre Tract	Number Acres To Be Irrigated	Date of Reclamation
8 S	1 W	31	NE¼ of NE¼	2.6	July 1947
8 S	1 W	31	NW¼ of NE¼	1.6	July 1947
8 S	1 W	31	SW¼ of NE¼	3.6	July 1947
8 S	1 W	31	SE¼ of NE¼	7.6	July 1947
				15.4	

15. If the ground water supply is supplemental to an existing water supply, identification of any application for a permit, permit, certificate or adjudicated right to appropriate water made or held by the registrant.

.....

.....

GR-2118

Township 8 S Range 1 W, W.M.

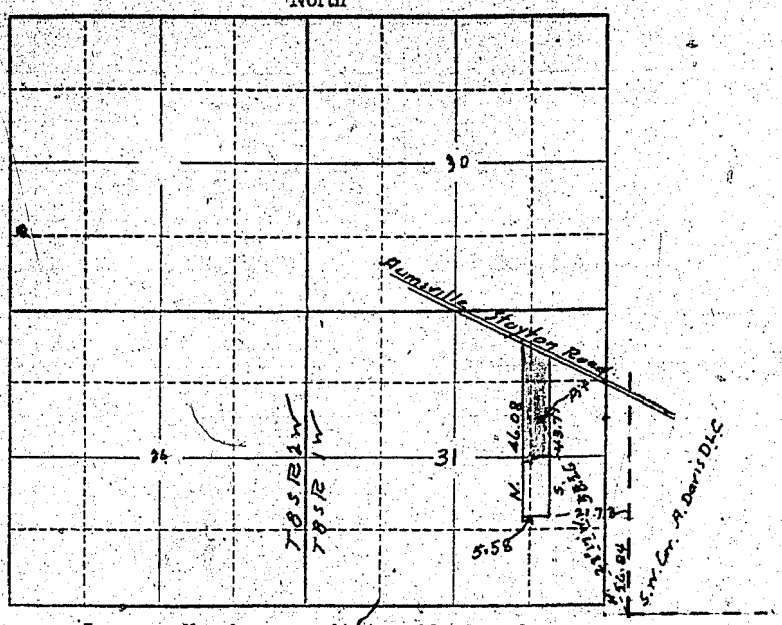

Locate well and acreage of irrigated land on plat.

Scale: 2" = 1 Mile

STATE OF OREGON }
County of Marion } ss.

I, William H. Bankston + Alberta M Bankston, being first duly sworn, do hereby certify that I have read the foregoing Registration Statement and that all of the items therein contained are true to the best of my knowledge and belief.

Alberta M Bankston
William H. Bankston
(Signature of Registrant)

Subscribed and sworn to before me this 29 day of June, 1956.

My commission expires 9/21/58

Walter H Beel
(Notary Public)

(SEAL)

CERTIFICATE OF REGISTRATION

STATE OF OREGON }
County of Marion } ss.

This is to certify that the foregoing Registration Statement was received in the office of the State Engineer on the 7th day of August, 1956, at 10:45 o'clock A. M. and has been duly recorded in said office in Book No. 2 of Registration Statements on page GR-211 C

~~Construction shall be completed by x-x-x-x-x-x-x-x-x-x-19 x-x- and the water completed applied to beneficial use by x-x-x-x-x-x-x-x-x-x-19x-x~~

Witness my hand this 23rd day of November, 1956.

Lewis A. Stanley
(State Engineer)

By
(Deputy)

GR-211C