

Registration No. GR-2301

Certificate No. GR 3899

# Registration Statement

## OF CLAIMANT OF RIGHT TO APPROPRIATE GROUND WATER

TO THE STATE ENGINEER OF OREGON:

I, Pete Veenstra

of Rt. 3, Box 555

County of Douglas

State of Oregon, do hereby make application for a certificate of registration as evidence of a right to appropriate ground water.

1. Source from which water is withdrawn is Pump Well #2  
(Flowing well, pump well, infiltration trench, or tunnel)
2. Location is: 6 miles West of Roseburg on Melrose Rd.  
(Approximate distance and direction from nearest city or town)

and is more particularly described as follows:

(a) 1584' N & 90' S of SW 1/4 D.L.C. #50  
(Give distance and bearing to corner of section or other legal subdivision)

being within NW 4 NW 4 of Sec. 9, Twp. 27S, Rge. 6W  
(Smallest legal subdivision) (N. of S.) (E. or W.)

or (b) within limits of recorded platted property, town or city:

in Lot \_\_\_\_\_, Block \_\_\_\_\_ of \_\_\_\_\_  
(Name of plat or addition)

County of \_\_\_\_\_  
(If within city or town, give name)

3. Construction Work was begun on Nov. 1949; was completed on Nov. 1949  
(Date) (Date)

and the ground water claimed was first used for the purposes set out below on Nov. 1949,  
(Date) since which time the water has been used continuously for stock & intermittently for irrigation  
(Continuously or intermittently) from Nov. 1949 to present date  
(Date) (Date)

4. Quantity of water claimed and used is 24 gpm gallons per minute; 5.3 acre feet per year.

5. Purpose or Purposes for which water is used irrigation, stock

(Domestic, irrigation, municipal, manufacturing, industrial, etc.)

6. Description of Well: Depth 60 feet. Type drilled  
(Dug or drilled)

diameter 8 inches. Elevation of ground at well site \_\_\_\_\_ feet, mean sea level.  
(As near as known)

Depth to water table 30 feet.

7. Capacity of Well: \_\_\_\_\_ g.p.m. with \_\_\_\_\_ feet drawdown.

\_\_\_\_\_ g.p.m. with \_\_\_\_\_ feet drawdown.

Date of test \_\_\_\_\_

If Flowing Well: Measured discharge \_\_\_\_\_ g.p.m. on \_\_\_\_\_  
(Date)

Shut-in pressure at ground surface \_\_\_\_\_ lbs. per sq. in. on \_\_\_\_\_  
(Date)

Water is controlled by \_\_\_\_\_  
(Cap, valve, etc.)






D.L.C. #51

Township 27S Range 6W, W.M.

North

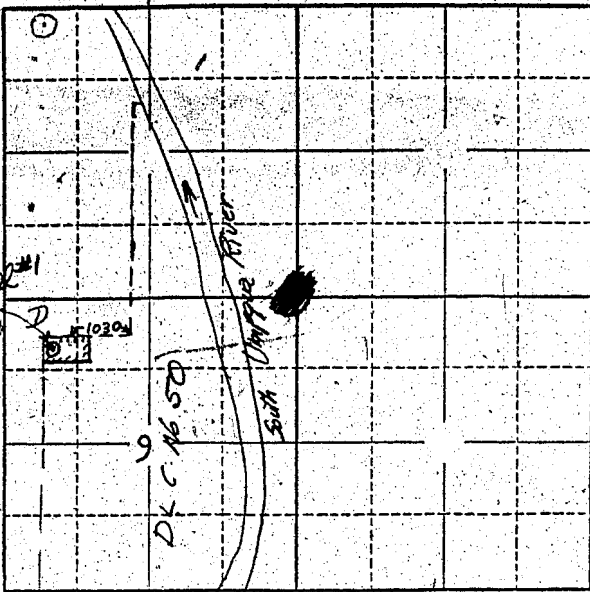

Locate well and acreage of irrigated land on plat.

Scale: 2" = 1 Mile

STATE OF OREGON

County of Douglas

ss.

I, Pete Veenstra, being first duly sworn, do hereby certify that I have read the foregoing Registration Statement and that all of the items therein contained are true to the best of my knowledge and belief.

*Pete Veenstra*  
(Signature of Registrant)

Subscribed and sworn to before me this 17th day of July, 1958

My commission expires 6/30/60

*Ch. Thompson*  
(Notary Public)

(SEAL)

CERTIFICATE OF REGISTRATION

STATE OF OREGON

County of Marion

ss.

This is to certify that the foregoing Registration Statement was received in the office of the State Engineer on the 18th day of July, 1958, at 8:00 o'clock A. M. and has been duly recorded in said office in Book No. 16 of Registration Statements on page GR-3899

Witness my hand this 15th day of February, 1960

*Laura A. Stanley*  
(State Engineer)

By \_\_\_\_\_ (Deputy)

15.00