

# Registration Statement

## OF CLAIMANT OF RIGHT TO APPROPRIATE GROUND WATER

#12

TO THE STATE ENGINEER OF OREGON:

I, Pete Veenstra  
 of Rt. 3, Box 555 County of Douglas  
(Mailing address)  
 State of Oregon, do hereby make application for a certificate of registration as evidence of a right to appropriate ground water.

1. Source from which water is withdrawn is Pump Well  
(Flowing well, pump well, infiltration trench, or tunnel)

2. Location is: 6 miles West of Roseburg, on Melrose Road  
(Approximate distance and direction from nearest city or town)

and is more particularly described as follows: Int. Cor W boundary for all or

(a) 1030' W & 40' S of SW Cor DLC #51  
(Give distance and bearing to corner of section or other legal subdivision)

being within NE 1/4 NW 4 of Sec. 9, Twp. 27, Rge. 6  
(Smallest legal subdivision) (N. or S.) (E. or W.)

or (b) within limits of recorded platted property, town or city:

in Lot \_\_\_\_\_, Block \_\_\_\_\_ of \_\_\_\_\_  
(Name of plat or addition)

County of \_\_\_\_\_  
(If within city or town, give name)

3. Construction Work was begun on May 1952, was completed on May 1952  
(Date) (Date)

and the ground water claimed was first used for the purposes set out below on \_\_\_\_\_  
(Date)

since which time the water has been used intermittently for irrigation  
(Continuously or intermittently)

from May 1952 to to present date  
(Date) (Date)

4. Quantity of water claimed and used is all well water is used gallons per minute; 34 acre  
 feet per year. 5

5. Purpose or Purposes for which water is used: Irrigation

6. Description of Well: Depth 60 feet. Type drilled  
(Domestic, irrigation, municipal, manufacturing, industrial, etc.) (Dug or drilled)

diameter 12 inches. Elevation of ground at well site \_\_\_\_\_ feet, mean sea level.  
(As near as known)

Depth to water table 30 feet.

7. Capacity of Well: \_\_\_\_\_ g.p.m. with \_\_\_\_\_ feet drawdown.  
 \_\_\_\_\_ g.p.m. with \_\_\_\_\_ feet drawdown.

Date of test \_\_\_\_\_

If Flowing Well: Measured discharge \_\_\_\_\_ g.p.m. on \_\_\_\_\_  
(Date)

Shut-in pressure at ground surface \_\_\_\_\_ lbs. per sq. in. on \_\_\_\_\_  
(Date)


Water is controlled by \_\_\_\_\_  
(Cap, valve, etc.)





D.L.C. #51

Township 27 S Range 6 W, W.M.  
North

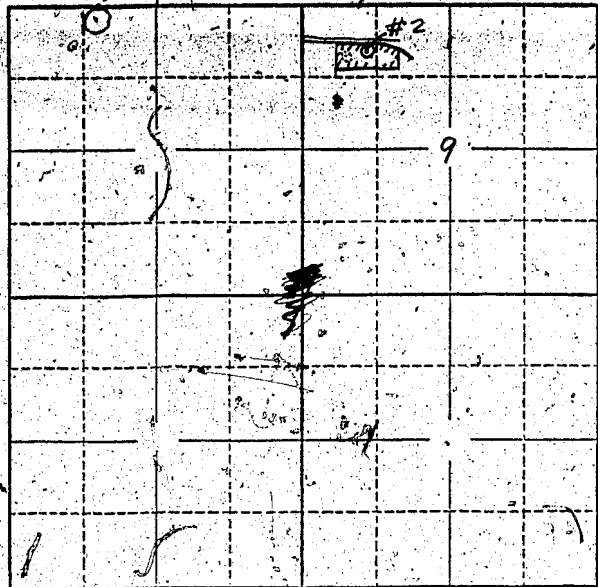

Locate well and acreage of irrigated land on plat.  
Scale: 2" = 1 Mile

STATE OF OREGON

County of Douglas } ss.

I, Pete Veenstra, being first duly sworn, do hereby certify that I have read the foregoing Registration Statement and that all of the items therein contained are true to the best of my knowledge and belief.

*Pete Veenstra*  
(Signature of Registrant)

Subscribed and sworn to before me this 17th day of July, 1958

My commission expires 6/30/60

*H. Thompson*  
(Notary Public)

(SEAL)

**CERTIFICATE OF REGISTRATION**

STATE OF OREGON

County of Marion } ss.

This is to certify that the foregoing Registration Statement was received in the office of the State Engineer on the 18th day of July, 1958, at 8:00 o'clock A. M. and has been duly recorded in said office in Book No. 16 of Registration Statements on page GR-3900

Witness my hand this 15th day of February, 1960

*Wm. A. Stanley*  
(State Engineer)

By \_\_\_\_\_ (Deputy)

\*\$15.00

GR 3900