

Registration Statement

OF CLAIMANT OF RIGHT TO APPROPRIATE GROUND WATER

TO THE STATE ENGINEER OF OREGON:

I, ARNE ELDER
of 1496 RIVER Rd County of LANE
(Mailing address)
State of OREGON, do hereby make application for a certificate of registration as evidence of a right to appropriate ground water.

Source from which water is withdrawn is PUMP
(Flowing well, pump well, infiltration trench, or tunnel)

2. Location is: 2 1/2 miles Southeast from Junction City
(Approximate distance and direction from nearest city or town)

and is more particularly described as follows:

(a) 1800'S & 1700'W from the NE Corner of Sec 4
(Give distance and bearing to corner of section or other legal subdivision)
being within SW 1/4 The NE 1/4 of Sec. 4, Twp. 16S, Rge. 4W
(Smallest legal subdivision) (N. or S.) (E. or W.)

or (b) within limits of recorded platted property, town or city:

in Lot _____ Block _____ of _____
(Name of plat or addition)

County of _____
(If within city or town, give name)

3. Construction Work was begun on APRIL 1949; was completed on Same
(Date) (Date)

and the ground water claimed was first used for the purposes set out below on MAY 1949
(Date)

since which time the water has been used _____
(Continuously or Intermittently)

from MAY to Oct
(Date) (Date)

4. Quantity of water claimed and used is 200 gallons per minute; 45 acre feet per year.

5. Purpose or Purposes for which water is used IRRIG

(Domestic, irrigation, municipal, manufacturing, industrial, etc.)

6. Description of Well: Depth 32 feet, Type DRIVEN
(Dug or drilled)

diameter 4 inches. Elevation of ground at well site 310 feet, mean sea level.
(As near as known)

Depth to water table 12 feet.

7. Capacity of Well: _____ g.p.m. with _____ feet drawdown.

_____ g.p.m. with _____ feet drawdown.


Date of test Not Tested

If Flowing Well: Measured discharge _____ g.p.m. on _____
(Date)

Shut-in pressure at ground surface _____ lbs. per sq. in. on _____
(Date)

Water is controlled by _____
(Cap, valve, etc.)

Township 16 S Range 4 W W.M.
North

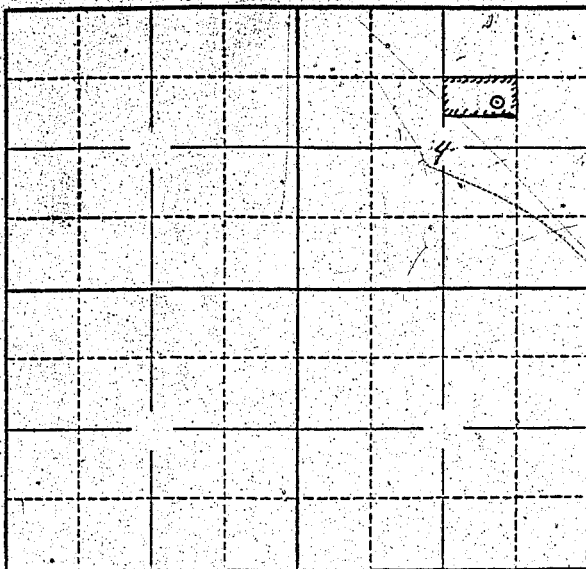

Locate well and acreage of irrigated land on plat.
Scale: 2" = 1 Mile

STATE OF OREGON

County of Lane } ss.

I, Arno Elbek, being first duly sworn, do hereby certify that I have read the foregoing Registration Statement and that all of the items therein contained are true to the best of my knowledge and belief.

Arno Elbek
(Signature of Registrant)

Subscribed and sworn to before me this 17th day of July, 1958.

My commission expires MY COMMISSION EXPIRES NOVEMBER 18, 1958 Christian S. Haske
(Notary Public)

(SEAL)

CERTIFICATE OF REGISTRATION

STATE OF OREGON

County of Marion } ss.

This is to certify that the foregoing Registration Statement was received in the office of the State Engineer on the 18th day of July, 1958, at 8:00 o'clock A. M. and has been duly recorded in said office in Book No. 10 of Registration Statements on page GR-2200

Witness my hand this 10th day of March, 1959.

Lewis A. Stanley
(State Engineer)

By _____
(Deputy)

GR - 2200

\$15.00