

# Registration Statement

## OF CLAIMANT OF RIGHT TO APPROPRIATE GROUND WATER

(Under Chapter 708, Oregon Laws 1955.)

RECEIVED  
MAY 19 1968  
STATE ENGINEER  
DAVID GREGG

TO THE STATE ENGINEER OF OREGON:

I, Robert E. Koester

of McMinnville County of Yamhill

State of Oregon, do hereby make application for a certificate of registration as evidence of a right to appropriate ground water.

1. Source from which water is withdrawn is Hand well  
(Flowing well, pumpwell, infiltration trench, or tunnel)

2. Location is: 2 miles N.E. of McMinnville  
(Approximate distance and direction from nearest city or town)

and is more particularly described as follows: 500 feet east & 100 feet north from SW Corner Sect. 14

(a) B' South of 1/2 in. App. at N.W. Cor. Lot 34 and N.E. Cor. Lot 35 of Riverside Orchards  
(Give distance and bearing to corner of section or other legal subdivision)

being within SW 1/4 of SW 1/4 of Sec. 14, Twp. 4S, Rge. 4W  
(Smallest legal subdivision) (N. or S.) (E. or W.)

or (b) within limits of recorded platted property, town or city: Lots 34 and 35

in Lot \_\_\_\_\_, Block \_\_\_\_\_ of Riverside Orchards  
(Name of plat or addition)

County of \_\_\_\_\_  
(If within city or town, give name)

3. Construction Work was begun on July 1, 1948; was completed on July 15, 1948  
(Date) (Date)

and the ground water claimed was first used for the purposes set out below on August 10, 1948  
(Date)

since which time the water has been used Seasonal  
(Continuously or Intermittently)

from May 1 to October 1  
(Date) (Date)

4. Quantity of water claimed and used is 35 gallons per minute; 6 acre feet per year.

5. Purpose or Purposes for which water is used Irrigation

(Domestic, irrigation, municipal, manufacturing, industrial, etc.)

6. Description of Well: Depth 114 feet. Type Drilled  
(Dug or drilled)

diameter 6 inches. Elevation of ground at well site 100 feet, mean sea level.  
(As near as known)

Depth to water table 10 feet.

7. Capacity of Well: 35 g.p.m. with 70 feet drawdown.

\_\_\_\_\_ g.p.m. with \_\_\_\_\_ feet drawdown.

Date of test July 15, 1948

If Flowing Well: Measured discharge \_\_\_\_\_ g.p.m. on \_\_\_\_\_  
(Date)

Shut-in pressure at ground surface \_\_\_\_\_ lbs. per sq. in. on \_\_\_\_\_  
(Date)

Water is controlled by \_\_\_\_\_  
(Cap, valve, etc.)

8. Casing: (Give diameter, commercial specifications and depth below ground surface of each casing size.)

6" OD inch diameter 1 3/4 Casing from 0 to 114 feet  
inch diameter from to feet  
inch diameter from to feet  
inch diameter from to feet

Describe and show depth of shoe, plug, adapter, liner or other details: Perforated Casing

9. Perforated Casings or Screens:

80 Perforations from 94 to 114  
(Number per foot and size of perforations, or describe screen)  
from to  
from to  
from to

10. Log of Well: (Describe each stratum or formation clearly, indicate if water bearing, and give thickness and depth as indicated.)

MATERIAL	Thickness (Feet)	Depth to Bottom (Feet)
Top Soil	0	2
Clay	2	21
Silty Clay	21	32
Blue Clay	32	67
Fine Sand	67	72
Blue Clay	72	94
Lens imbedded in Sand	94	114

Well was drilled by Wilcox Drilling Co. P.O. Box 566 Madras, Ore.  
and this log may not be accurate as to the exact depth of different formations.

J. L. Wilcox

If log of well is not available, give name and address of driller. \_\_\_\_\_

11. Infiltration Trench: Covered or open \_\_\_\_\_

Dimensions: Length \_\_\_\_\_ ft. Minimum depth \_\_\_\_\_ ft. Maximum depth \_\_\_\_\_ ft.

Bottom width \_\_\_\_\_ ft. Discharge \_\_\_\_\_ g.p.m. Date of test \_\_\_\_\_

12. Tunnel: Type of lining \_\_\_\_\_

Dimensions: \_\_\_\_\_  
(Length, course, and cross sectional size)

Position of water bearing stratum with reference to portal of tunnel \_\_\_\_\_

Log of tunnel: (Preceding table for log of well may be used, if desired. Give footage from portal and character of materials, as pertinent.) \_\_\_\_\_

13. Pumping Equipment:

(a) Pump Fairbanks Morse (Little Chief) Capacity 35 g.p.m.  
(Make, type and size)


(b) Motor Fairbanks Morse Capacitor 3 HP  
(Type and horsepower)

14. Location of area irrigated or to be irrigated, or place of use if for purposes other than irrigation.

Township North or South	Range E. or W. of Willamette Meridian	Section	Forty-acre Tract	Number Acres To Be Irrigated	Date of Reclamation
4 S	4 W	14			
		15			

15. If the ground water supply is supplemental to an existing water supply, identification of any application for a permit, permit, certificate or adjudicated right to appropriate water made or held by the registrant.

Township 4S Range 4W, W.M.  
North

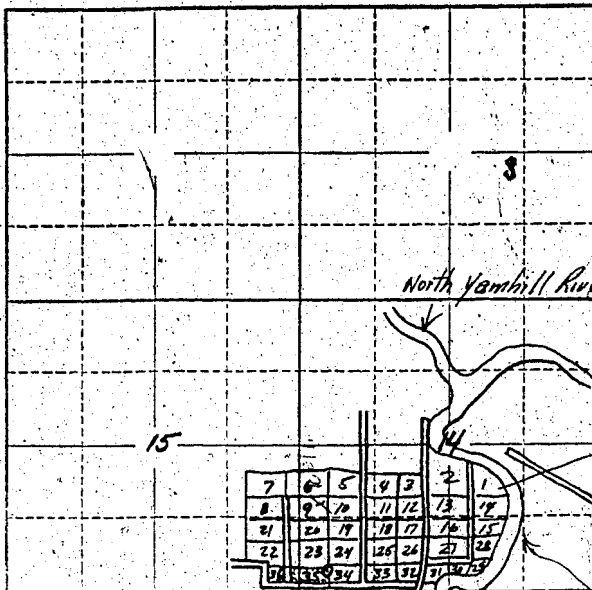

Locate well and acreage of irrigated land on plat.

Scale: 2" = 1 Mile

SE 1/4 of SE 1/4 Sec 15 1 Ac  
SW 1/4 of SW 1/4 Sec 14 2 Ac  
Being in Lots 35 and 36 of  
Riverside Orchards.

STATE OF OREGON

County of Yamhill

I, Robert F. Koester, being first duly sworn, do hereby certify that I have read the foregoing Registration Statement and that all of the items therein contained are true to the best of my knowledge and belief.

*Robert F. Koester*  
(Signature of Registrant)

Subscribed and sworn to before me this 17 day of July, 1958.

My commission expires Jan. 26, 1959

*Lawrence E. Ryan*  
(Notary Public)

(SEAL)

**CERTIFICATE OF REGISTRATION**

STATE OF OREGON

County of Marion

This is to certify that the foregoing Registration Statement was received in the office of the State Engineer on the 18th day of July, 1958, at 9:00 o'clock A. M. and has been duly recorded in said office in Book No. 16 of Registration Statements on page GR 4007

~~Construction shall be completed by 19 and the water completely applied to beneficial use by 19.~~

Witness my hand this 15th day of March, 1960.

\$15.00

*Lawrence E. Ryan*  
(State Engineer)

By \_\_\_\_\_ (Deputy)

**GR-4007**