

Registration No. GR GR2311

Certificate No. GR-2207

STATE ENGINEER
SALEM, OREGON

Registration Statement

OF CLAIMANT OF RIGHT TO APPROPRIATE GROUND WATER

TO THE STATE ENGINEER OF OREGON:

I, Vern Sanford
of Rt. 1, Box 26 A, Newberg County of Yamhill
(Mailing address)

State of Oregon, do hereby make application for a certificate of registration as evidence of a right to appropriate ground water.

1. Source from which water is withdrawn is pump well
(Flowing well, pump well, infiltration trench, or tunnel)

2. Location is: 1 1/2 miles north of Newberg on Hwy. 219
(Approximate distance and direction from nearest city or town)

and is more particularly described as follows:

(a) N35° W 2115' from S.E. corner Sec. 7, Twp. 3S., Rng. 2 W
(Give distance and bearing to corner of section or other legal subdivision)

being within NE 1/4 of SE 1/4 of Sec. 7, Twp. 3 S., Rge. 2 W.
(Smallest legal subdivision) (N. or S.) (E. or W.)

or (b) within limits of recorded platted property, town or city:

in Lot _____, Block _____ of _____
(Name of plat or addition)
County of _____
(If within city or town, give name)

3. Construction Work was begun on August 1951; was completed on October 1951
(Date) (Date)

and the ground water claimed was first used for the purposes set out below on May 1952
(Date)

since which time the water has been used continuously
(Continuously or intermittently)

from May 1952 to July 1958
(Date) (Date)

4. Quantity of water claimed and used is 56 gallons per minute; _____ acre feet per year.

5. Purpose or Purposes for which water is used irrigation

(Domestic, irrigation, municipal, manufacturing, industrial, etc.)

6. Description of Well: Depth 360 feet. Type drilled
(Dug or drilled)

diameter 8" inches. Elevation of ground at well site 185 feet, mean sea level
(As near as known)

Depth to water table 100 feet.

7. Capacity of Well: 100 g.p.m. with 160 feet drawdown.
_____ g.p.m. with _____ feet drawdown.

Date of test October 1951

If Flowing Well: Measured discharge _____ g.p.m. on _____
(Date)

Shut-in pressure at ground surface _____ lbs. per sq. in. on _____
(Date)

Water is controlled by _____
(Cap, valve, etc.)

8. Casing: (Give diameter, commercial specifications and depth below ground surface of each casing size.)

8 inch diameter from 0 to 250 feet
 6 inch diameter from 250 to 360 feet
 inch diameter from to feet
 inch diameter from to feet

Describe and show depth of shoe, plug, adapter, liner or other details:

9. Perforated Casings or Screens:

6 per foot with torch from 326 to 338
(Number per foot and size of perforations, or describe screen)
 6 per foot with torch from 344 to 356
 from to
 from to

10. Log of Well: (Describe each stratum or formation clearly, indicate if water bearing, and give thickness and depth as indicated.)

MATERIAL	Thickness (Feet)	Depth to Bottom (Feet)

If log of well is not available, give name and address of driller. Barron & Strayer, Sorrento Road,
Beaverton, Oregon

11. Infiltration Trench: Covered or open

Dimensions: Length ft. Minimum depth ft. Maximum depth ft.

Bottom width ft. Discharge g.p.m. Date of test

12. Tunnel: Type of lining

Dimensions:
(Length, course, and cross sectional size)

Position of water bearing stratum with reference to portal of tunnel

Log of tunnel: (Preceding table for log of well may be used, if desired. Give footage from portal and character of materials, as pertinent.)

13. Pumping Equipment:

(a) Pump Pacific-Beresford Submersible 3" Capacity 125 g.p.m.
(Make, type and size)


(b) Motor 10 HP 30 220 V
(Type and horsepower)

14. Location of area irrigated or to be irrigated, or place of use if for purposes other than irrigation.

Township North or South	Range E. or W. of Willamette Meridian	Section	Forty-acre Tract	Number Acres To Be Irrigated	Date of Reclamation
3 S	2 W	7	NW $\frac{1}{4}$ of SE $\frac{1}{4}$	6.1	May 1952
3 S	2 W	7	NE $\frac{1}{4}$ of SE $\frac{1}{4}$	5.9	May 1952
Total				12.0	

15. If the ground water supply is supplemental to an existing water supply, identification of any application for a permit, permit, certificate or adjudicated right to appropriate water made or held by the registrant.

Township 3S Range 2W W.M.
North

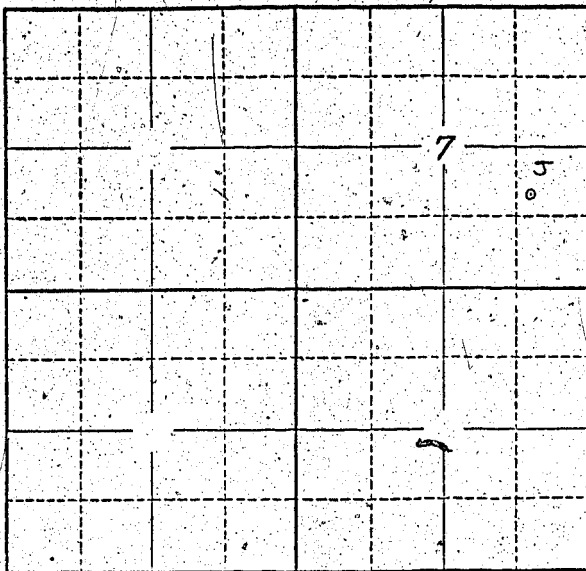

Locate well and acreage of irrigated land on plat.
Scale: 2" = 1 Mile

STATE OF OREGON

County of Washburn } ss.

I, Wm Stanford, being first duly sworn, do hereby certify that I have read the foregoing Registration Statement and that all of the items therein contained are true to the best of my knowledge and belief.

Wm Stanford
(Signature of Registrant)

Subscribed and sworn to before me this 17th day of June, 1958

My commission expires Sept 29, 1961 Erving M. Casey Jr
(Notary Public)

(SEAL)

CERTIFICATE OF REGISTRATION

STATE OF OREGON } ss.
County of Marion

This is to certify that the foregoing Registration Statement was received in the office of the State Engineer on the 19th day of July, 1958, at 8:00 o'clock A.M. and has been duly recorded in said office in Book No. 10 of Registration Statements on page GR 2202.

Witness my hand this 10th day of March, 1959

Lewis A. Stanley
(State Engineer)

\$1500

By _____ (Deputy)

GR 2202