

Registration No. GR - 2312

Certificate No. GR - 2203

Registration Statement

OF CLAIMANT OF RIGHT TO APPROPRIATE GROUND WATER

TO THE STATE ENGINEER OF OREGON:

I, Elvin T. and Clara V. Finegan
of Route 2 Box 54 Cornelius County of WASHINGTON
(Mailing address)

State of Oregon do hereby make application for a certificate of registration as evidence of a right to appropriate ground water.

- Source from which water is withdrawn is Pump Well
(Flowing well, pump well, infiltration trench, or tunnel)
- Location is: 1/4 Mile West and 1/4 Mile South from City of Cornelius.
(Approximate distance and direction from nearest city or town)

and is more particularly described as follows:

(a) S 60° 0' E From NW Corner Sec. 4
(Give distance and bearing to corner of section or other legal subdivision)
being within NW 1/4 of NW 1/4 of Sec. 4, Twp. 15 Rge. 3 W
(Smallest legal subdivision) (N. or S.) (E. or W.)

or (b) within limits of recorded platted property, town or city:

in Lot _____, Block _____ of _____
(Name of plat or addition)
County of WASHINGTON
(If within city or town, give name)

3. Construction Work was begun on May 1949; was completed on MAY 1949
(Date) (Date)

and the ground water claimed was first used for the purposes set out below on June 1949
(Date)

since which time the water has been used Intermittently
(Continuously or Intermittently)

from May 1 each year to Oct 1 each year
(Date) (Date)

4. Quantity of water claimed and used is 42 gallons per minute; 470,750 acre feet per year.

5. Purpose or Purposes for which water is used Irrigation
(Domestic, irrigation, municipal, manufacturing, industrial, etc.)

6. Description of Well: Depth 92 feet. Type Drilled
(Dug or drilled)

diameter 6 inches. Elevation of ground at well site 210' feet, mean sea level.
(As near as known)

Depth to water table 8 to 10 feet.

7. Capacity of Well: 42 g.p.m. with 30 feet drawdown.
_____ g.p.m. with _____ feet drawdown.

Date of test Aug 1957

If Flowing Well: Measured discharge _____ g.p.m. on _____
(Date)

Shut-in pressure at ground surface _____ lbs. per sq. in. on _____
(Date)

Water is controlled by _____
(Cap, valve, etc.)

8. Casing: (Give diameter, commercial specifications and depth below ground surface of each casing size.)

6 inch diameter *Steel Well Casing* from *Surface* to *55* feet
..... inch diameter from to feet
..... inch diameter from to feet
..... inch diameter from to feet

Describe and show depth of shoe, plug, adapter, liner or other details:
None

9. Perforated Casings or Screens:

None from to
(Number per foot and size of perforations, or describe screen)
..... from to
..... from to
..... from to

10. Log of Well: (Describe each stratum or formation clearly, indicate if water bearing, and give thickness and depth as indicated.)

MATERIAL	Thickness (Feet)	Depth to Bottom (Feet)
<i>Not available</i>		

If log of well is not available, give name and address of driller.

CARL MILLET Hillsboro, Oregon.

11. Infiltration Trench: Covered or open NONE

Dimensions: Length ft. Minimum depth ft. Maximum depth ft.

Bottom width ft. Discharge g.p.m. Date of test

12. Tunnel: Type of lining NONE

Dimensions:
(Length, course, and cross sectional size)

Position of water-bearing stratum with reference to portal of tunnel

Log of tunnel: (Preceding table for log of well may be used, if desired. Give footage from portal and character of materials, as pertinent.)

13. Pumping Equipment:

(a) Pump Meyers Ejector E-107 Jet Pump Capacity 50 g.p.m.
(Make, type and size)


(b) Motor G.E. Electric Motor 1 1/2 H.P.
(Type and horsepower)

14. Location of area irrigated or to be irrigated, or place of use if for purposes other than irrigation.

Township North or South	Range E. or W. of Willamette Meridian	Section	Forty-acre Tract	Number Acres To Be Irrigated	Date of Reclamation
15	3W	4	NW 1/4 of NW 1/4	16.0	June 1949
15	3W	4	SW 1/4 of NW 1/4	2.0	June 1949
15	3W	4	NE 1/4 of NW 1/4	5.0	June 1949
15	3W	4	SE 1/4 of NW 1/4	0.8	June 1949
				<u>18.8 Ac</u>	

15. If the ground water supply is supplemental to an existing water supply, identification of any application for a permit, permit, certificate or adjudicated right to appropriate water made or held by the registrant.

Township 15 Range 3W W.M.
North

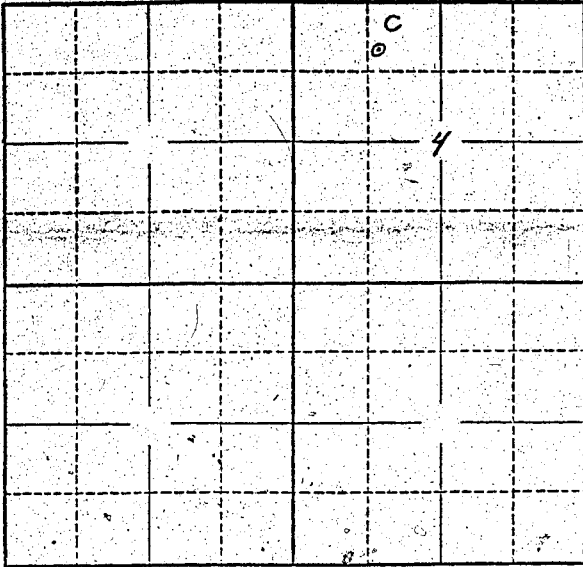

Locate well and acreage of irrigated land on plat.
Scale: 2" = 1 Mile

STATE OF OREGON }
County of Washington } ss.

I, Edwin T. Finegan, being first duly sworn, do hereby certify that I have read the foregoing Registration Statement and that all of the items therein contained are true to the best of my knowledge and belief.

Edwin T. Finegan
(Signature of Registrant)

Subscribed and sworn to before me this 15 day of July, 1958

My commission expires 2-6-62
[Signature]
(Notary Public)

(SEAL)

CERTIFICATE OF REGISTRATION

STATE OF OREGON }
County of Marion } ss.

This is to certify that the foregoing Registration Statement was received in the office of the State Engineer on the 18th day of July, 1958, at 2:00 o'clock A. M. and has been duly recorded in said office in Book No. 10 of Registration Statements on page GR-2203

Witness my hand this 10th day of March, 1959

[Signature]
(State Engineer)

\$15.00

By _____
(Deputy)