

Registration No. GR-2313

Certificate No. GR-2204

STATE ENGINEER
SALEM, OREGON

Registration Statement

OF CLAIMANT OF RIGHT TO APPROPRIATE GROUND WATER

TO THE STATE ENGINEER OF OREGON:

I, Elvin T. and Clara V. Finegan
of Route 2 Box 54 Cornelius County of WASHINGTON
(Mailing address)

State of Oregon, do hereby make application for a certificate of registration as evidence of a right to appropriate ground water.

1. Source from which water is withdrawn is Pump Well
(Flowing well, pump well, infiltration trench, or tunnel)
2. Location is: 1/4 Mile West of 1/4 Mile South from City of Cornelius
(Approximate distance and direction from nearest city or town)

and is more particularly described as follows:

(a) S 84° W 1370' from Center of Section 7
(Give distance and bearing to corner of section or other legal subdivision)
being within NW 1/4 of SW 1/4 of Sec. 7, Twp. 15, Rge. 3 W
(Smallest legal subdivision) (N. or S.) (E. or W.)

or (b) within limits of recorded platted property, town or city:

in Lot _____, Block _____ of _____
(Name of plat or addition)
County of WASHINGTON
(If within city or town, give name)

3. Construction Work was begun on May 1949; was completed on May 1949
(Date) (Date)

and the ground water claimed was first used for the purposes set out below on Jan 1949
(Date)

since which time the water has been used Intermittently
(Continuously or intermittently)

from May 1 Each year to Oct 1 Each year
(Date) (Date)

4. Quantity of water claimed and used is 42 gallons per minute; 45 acre feet per year.

5. Purpose or Purposes for which water is used Irrigation

(Domestic, irrigation, municipal, manufacturing, industrial, etc.)

6. Description of Well: Depth 65 feet. Type Drilled
(Dug or drilled)

diameter 6 inches. Elevation of ground at well site 7210' feet, mean sea level.
(As near as known)

Depth to water table 8-10 feet.

7. Capacity of Well: 40 g.p.m. with 20 feet drawdown.
_____ g.p.m. with _____ feet drawdown.


Date of test SEPT 1957

If Flowing Well: Measured discharge _____ g.p.m. on _____ (Date)

Shut-in pressure at ground surface _____ lbs. per sq. in. on _____ (Date)

Water is controlled by _____
(Cap, valve, etc.)

Township 15 Range 3W W.M.
North

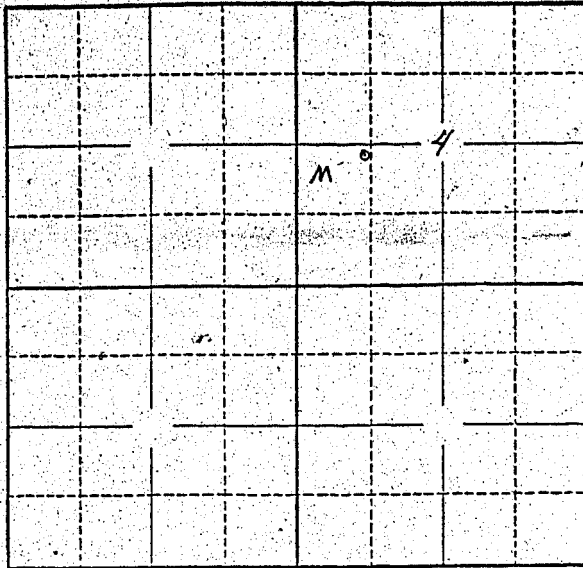

Locate well and acreage of irrigated land on plat.
Scale: 2" = 1 Mile

STATE OF OREGON }
County of Washington } ss.

Wm. T. Finegan, being first duly sworn, do hereby certify that I have read the foregoing Registration Statement and that all of the items therein contained are true to the best of my knowledge and belief.

Wm. T. Finegan
(Signature of Registrant)

Subscribed and sworn to before me this 15 day of July, 1958

My commission expires 2-6-62
L. B. Vietmeier
(Notary Public)

(SEAL)

CERTIFICATE OF REGISTRATION

STATE OF OREGON }
County of Marion } ss.

This is to certify that the foregoing Registration Statement was received in the office of the State Engineer on the 18th day of July, 1958 at 8:00 o'clock A. M. and has been duly recorded in said office in Book No. 10 of Registration Statements on page GR-2204

Witness my hand this 10th day of March, 1959

Lewis A. Stanley
(State Engineer)

By _____
(Deputy)

\$15.00

GR-2204