



Registration No. GR-2315

Certificate No. GR-2205

Registration Statement

OF CLAIMANT OF RIGHT TO APPROPRIATE GROUND WATER

TO THE STATE ENGINEER OF OREGON:

I, Harold L. And (Or) Carvel L. Wall

of Box 488 Rt. 2 County of Jackson
(Mailing address)

State of Oregon do hereby make application for a certificate of registration as evidence of a right to appropriate ground water.

1. Source from which water is withdrawn is Pump Well
(Flowing well, pump well, infiltration trench, or tunnel)

2. Location is: 5 Miles West of Medford, Oregon
(Approximate distance and direction from nearest city or town)

and is more particularly described as follows:

(a) 540' S and 1465' W From N. E. Corner Sec. 28
(Give distance and bearing to corner of section or other legal subdivision)

being within Donation Land Claim #67 of Sec. 28, Twp. 37S, Rge. 2-W
(Smallest legal subdivision) (N. or S.) (E. or W.)

or (b) within limits of recorded platted property, town or city:

in Lot _____, Block _____ of _____
(Name of plat or addition)

County of Jackson
(If within city or town, give name)

3. Construction Work was begun on June, 1951, was completed on July 1951
(Date) (Date)

and the ground water claimed was first used for the purposes set out below on July 1951
(Date)

since which time the water has been used Continuously Summer Months
(Continuously or intermittently)

from July 1951 to Present Date
(Date) (Date)

4. Quantity of water claimed and used is 1500 - 2000 gallons per 349pm minute; 9.0 acre feet per year. Hour

5. Purpose or Purposes for which water is used Irrigation - Garden, Lawn and
Approx. 1 1/3 Pasture
(Domestic, irrigation, municipal, manufacturing, industrial, etc.)

6. Description of Well: Depth 16 feet. Type Dug
(Dug or drilled)

diameter 36 inches. Elevation of ground at well site 1310 feet, mean sea level.
(As near as known)

Depth to water table 8 = 10 feet.

7. Capacity of Well: 1500-2000 g.p.m. with 1 - 2 feet drawdown.

_____ g.p.m. with _____ feet drawdown.

Date of test July, 1951

If Flowing Well: Measured discharge _____ g.p.m. on _____
(Date)

Shut-in pressure at ground surface _____ lbs. per sq. in. on _____
(Date)


Water is controlled by _____
(Cap, valve, etc.)

Township 37 S. Range 2 W. W.M. North

Approx. 15' From West Property Line. 100' South of North Property Line

Legal Description of Property

Beginning at a point on the West line of and North 0° 02' East, 1803.22 Feet from the Southwest corner of Donation Land Claim #67, in Township 37 South, Range 2 West of the Willamette Meridian in Jackson County, Oregon; thence along said line, North 0° 02' East, 442.2 Feet; thence East, 368.52 feet to the Westerly line of road; thence along said line, South 39° 50' West, 575.00 feet to the point of beginning.

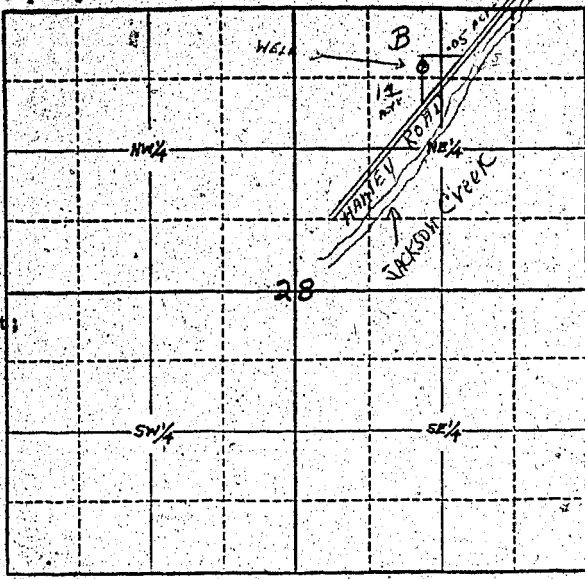

Locate well and acreage of irrigated land on plat.
Scale: 4" = 1 Mile

STATE OF OREGON

County of Jackson } ss.

I, Harold L. Wall, being first duly sworn, do hereby certify that I have read the foregoing Registration Statement and that all of the items therein contained are true to the best of my knowledge and belief.

Harold L. Wall
(Signature of Registrant)

Subscribed and sworn to before me this 14th day of July, 1958

My commission expires June 25, 1958

Paul Meddiffe
(Notary Public)

(SEAL)

CERTIFICATE OF REGISTRATION

STATE OF OREGON

County of Marion } ss.

This is to certify that the foregoing Registration Statement was received in the office of the State Engineer on the 18th day of July, 1958, at 8:00 o'clock A. M. and has been duly recorded in said office in Book No. 10 of Registration Statements on page GR 2205

Witness my hand this 10th day of March, 1959

Lewia A. Stanley
(State Engineer)

By _____ (Deputy)

\$15.00

GR 2205