RECEIVED
AUG 1 1956
STATE ENGINEER
SALEM, OREGON

REGISTRATION NO. GR-232
CERTIFICATE NO. GR-212

Registration Statement

OF CLAIMANT OF RIGHT TO APPROPRIATE GROUND WATER

(Under Chapter 708, Oregon Laws 1955.)

TO THE STATE ENGINEER OF OREGON:

I, Max, Elizabeth and Clara Burkhart,

of Rt. 2, Box 216, Lebanon County of Linn

State of Oregon, do hereby make application for a certificate of registration as evidence of a right to appropriate ground water.

1. **Source** from which water is withdrawn is pump well 3
(Flowing well, pump well, infiltration trench, or tunnel)

2. **Location** is: 3 miles north of Lebanon, Oregon;
(Approximate distance and direction from nearest city or town)

and is more particularly described as follows:

(a) S. 38° 15' E. 18.45 chains from NW corner D.L.C. 57
(Give distance and bearing to corner of section or other legal subdivision)

being within SW¼ of NW¼ of Sec. 26, Twp. 11 S (N. or S.), Rge. 2 W (E. or W.)
(Smallest legal subdivision)

or (b) within limits of recorded platted property, town or city:

in Lot ....., Block ..... of .....
(Name of plat or addition)

..... County of Linn
(If within city or town, give name)

3. **Construction Work** was begun on Mar. 3, 1950 (Date); was completed on Mar. 9, 1950 (Date)

and the ground water claimed was first used for the purposes set out below on June 15, 1950 (Date),

since which time the water has been used continuously
(Continuously or intermittently)

from June 15, '50 (Date) to present time (Date)

4. **Quantity** of water claimed and used is 500 gallons per minute; 98 acre feet per year.

5. **Purpose or Purposes** for which water is used irrigation
(Domestic, irrigation, municipal, manufacturing, industrial, etc.)

6. **Description of Well:** Depth 30 feet. Type drilled (Dug or drilled)

diameter 10 inches. Elevation of ground at well site 300 (As near as known) feet, mean sea level.

Depth to water table 12 feet.

7. **Capacity of Well:** 700 g.p.m. with 3 feet drawdown.

..... g.p.m. with ..... feet drawdown.

Date of test .....

If Flowing Well: Measured discharge ..... g.p.m. on ..... (Date)

Shut-in pressure at ground surface ..... lbs. per sq. in. on ..... (Date)

Water is controlled by ..... (Cap, valve, etc.)

8. **Casing:** (Give diameter, commercial specifications and depth below ground surface of each casing size.)

8 inch diameter steel casing from 0 to 25 feet

..... inch diameter ..... from ..... to ..... feet

..... inch diameter ..... from ..... to ..... feet

..... inch diameter ..... from ..... to ..... feet

Describe and show depth of shoe, plug, adapter, liner or other details: .....

9. **Perforated Casings or Screens:**

All three casings perforated all the way from ..... to .....
(Number per foot and size of perforations, or describe screen)

..... from ..... to .....

..... from ..... to .....

..... from ..... to .....

10. **Log of Well:** (Describe each stratum or formation clearly, indicate if water bearing, and give thickness and depth as indicated.)

MATERIAL	Thickness (Feet)	Depth to Bottom (Feet)
Information not available		

GR-212 A

If log of well is not available, give name and address of driller. Roscoe West, Salem, Oregon

11. **Infiltration Trench:** Covered or open .....

Dimensions: Length ..... ft. Minimum depth ..... ft. Maximum depth ..... ft.

Bottom width ..... ft. Discharge ..... g.p.m. Date of test .....

12. **Tunnel:** Type of lining .....

Dimensions: .....
(Length, course, and cross sectional size)

Position of water bearing stratum with reference to portal of tunnel .....

Log of tunnel: (Preceding table for log of well may be used, if desired. Give footage from portal and character of materials, as pertinent.)

13. **Pumping Equipment:**

(a) Pump 3" Fairbanks Morse centrifugal (Make, type and size) Capacity 600 g.p.m.

(b) Motor 15 H.P. (Type and horsepower)

14. Location of area irrigated or to be irrigated, or place of use if for purposes other than irrigation.

Township North or South	Range E. or W. of Willamette Meridian	Section	Forty-acre Tract	Number Acres To Be Irrigated	Date of Reclamation
11 S	2 W	27	SE¼ of NE¼	17.5	June 15, ~~1950~~ 1952
11 S	2 W	27	NE¼ of SE¼	2.1	"
11 S	2 W	26	SW¼ of NW¼	17.1	"
11 S	2 W	26	NW¼ of SW¼	2.2	"
				39.5	

15. If the ground water supply is supplemental to an existing water supply, identification of any application for a permit, permit, certificate or adjudicated right to appropriate water made or held by the registrant.

GR-212 B

Township 11S Range 2W, W.M.

North

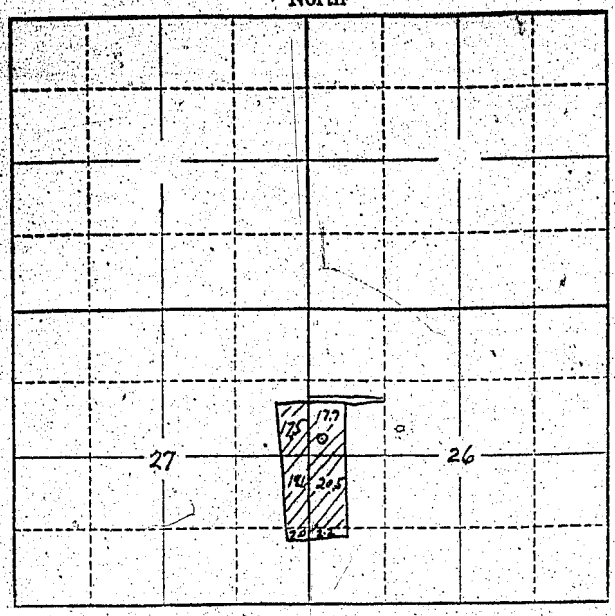

Locate well and acreage of irrigated land on plat.

Scale: 2" = 1 Mile

STATE OF OREGON
County of Linn } ss.

I, Max, Elizabeth and Clara Burkhart, being first duly sworn, do hereby certify that I have read the foregoing Registration Statement and that all of the items therein contained are true to the best of my knowledge and belief.

Max Burkhart
Clara Burkhart
Elizabeth Burkhart
(Signature of Registrant)

Subscribed and sworn to before me this 27th day of July, 1956

My commission expires July 13, 1958

Alta Nelson
(Notary Public)

(SEAL)

CERTIFICATE OF REGISTRATION

STATE OF OREGON
County of Marion } ss.

This is to certify that the foregoing Registration Statement was received in the office of the State Engineer on the 7th day of August, 1956, at 11 o'clock A. M. and has been duly recorded in said office in Book No. 2 of Registration Statements on page GR-212 C.

~~Certification shall be completed by x-x-x-x-x-x-x-x-x-x-x-x and the water completely applied to beneficial use by x-x-x-x-x-x-x-x-x-x-x-x.~~

Witness my hand this 23rd day of November, 1956

Lewis A. Stanley
(State Engineer)

By
(Deputy)

GR-212C