

# Registration Statement

## OF CLAIMANT OF RIGHT TO APPROPRIATE GROUND WATER

### TO THE STATE ENGINEER OF OREGON:

I, Rupert B Edwards

of 2410 River Road, Junction City County of Lane

State of Oregon, do hereby make application for a certificate of registration as evidence of a right to appropriate ground water.

1. Source from which water is withdrawn is Pump well

2. Location is: 3 1/2 miles southeast of Junction City

and is more particularly described as follows:

(a) 1874 ft south and 18 ft west from the NE corner of NW 1/4  
of section 16, 34th, BRW.  
being within SE 1/4 of the NW 1/4 of Sec. 9, Twp. 16 S, Rge. 4 west

(b) within limits of recorded platted property, town or city:

in Lot \_\_\_\_\_, Block \_\_\_\_\_ of \_\_\_\_\_  
County of Lane

3. Construction Work was begun on 15 July 1955; was completed on 16 July 1955

and the ground water claimed was first used for the purposes set out below on 16 July 1955

since which time the water has been used Continuously

from July 16, 1955 to present

4. Quantity of water claimed and used is 35 gallons per minute; 60 g.p.m. acre

5. Purpose or Purposes for which water is used Paper mill Distillery, Water  
supply to fill spray tanks, etc.

6. Description of Well: Depth 25 feet. Type driven  
diameter 2 inches. Elevation of ground at well site 355 feet, mean sea level.  
Depth to water table 12 feet.

7. Capacity of Well: 150 g.p.m. with 5 feet drawdown.  
         g.p.m. with          feet drawdown.

Date of test July 10, 1955

If Flowing Well: Measured discharge          g.p.m. on          (Date)


Shut-in pressure at ground surface          lbs. per sq. in. on          (Date)

Water is controlled by          (Cap, valve, etc.)





Township 16 S Range 4 W W.M.  
North

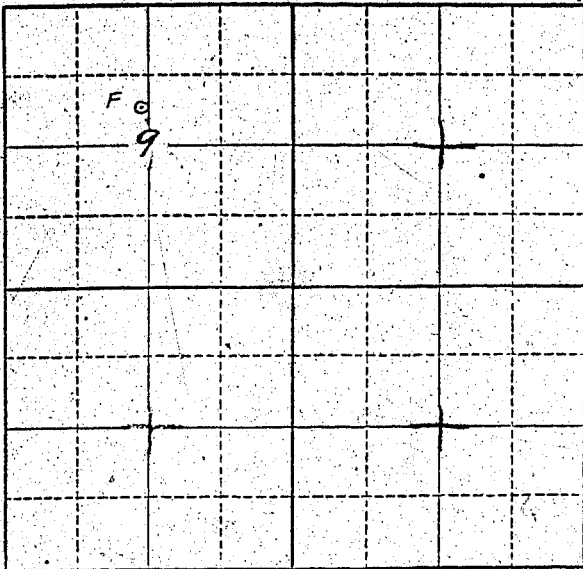

Locate well and acreage of irrigated land on plat.  
Scale: 2" = 1 Mile

STATE OF OREGON

County of Lane } ss.

I, Rupert B. Edwards being first duly sworn, do hereby certify that I have read the foregoing Registration Statement and that all of the items therein contained are true to the best of my knowledge and belief.

Rupert B. Edwards  
(Signature of Registrant)

Subscribed and sworn to before me this 17th day of July 19 58.

My commission expires March 13, 1961

Wesley D. [Signature]  
(Notary Public)

(SEAL)

**CERTIFICATE OF REGISTRATION**

STATE OF OREGON

County of Marion } ss.

This is to certify that the foregoing Registration Statement was received in the office of the State Engineer on the 18th day of July, 1958, at 2:00 o'clock A.M. and has been duly recorded in said office in Book No. 10 of Registration Statements on page GR-2210

Witness my hand this 10th day of March 19 59

Lewis A. Stanley  
(State Engineer)

\$ 20.00

By \_\_\_\_\_ (Deputy)