

Registration Statement

OF CLAIMANT OF RIGHT TO APPROPRIATE GROUND WATER

TO THE STATE ENGINEER OF OREGON:

1. Carrol Johnson

of 620 Hayes Lane

(Mailing address)

County of Lane

State of Ore., do hereby make application for a certificate of registration as evidence of a right to appropriate ground water.

1. Source from which water is withdrawn is Pump Well #1

(Flowing well, pump well, infiltration trench, or tunnel)

2. Location is: 3 mi. South 1/2 mi. E. of Junction City

(Approximate distance and direction from nearest city or town)

and is more particularly described as follows:

(a) 515 ft. N. & 352 ft. W. from S.W. corner Sec. 10

(Give distance and bearing to corner of section or other legal subdivision)

being within SE 1/4 of SW 1/4 of Sec. 10, Twp. 16 S., Rge. 4 W.

(Smallest legal subdivision)

(N. or S.)

(E. or W.)

or (b) within limits of recorded platted property, town or city:

in Lot _____, Block _____ of _____

(Name of plat or addition)

County of _____

(If within city or town, give name)

3. Construction Work was begun on April 1940; was completed on May 1940

(Date)

(Date)

and the ground water claimed was first used for the purposes set out below on June 1940

(Date)

since which time the water has been used intermittently

(Continuously or Intermittently)

from June 1940 to present

(Date)

(Date)

4. Quantity of water claimed and used is 360 gallons per minute; 68.8 acre feet per year.

5. Purpose or Purposes for which water is used irrigation

(Domestic, irrigation, municipal, manufacturing, industrial, etc.)

6. Description of Well: Depth 27 feet. Type Driven

(Dug or drilled)

diameter 4 inches. Elevation of ground at well site 335 feet, mean sea level.

(As near as known)

Depth to water table 13 feet.

7. Capacity of Well: _____ g.p.m. with _____ feet drawdown.

_____ g.p.m. with _____ feet drawdown.

Date of test No test

If Flowing Well: Measured discharge _____ g.p.m. on _____

(Date)

Shut-in pressure at ground surface _____ lbs. per sq. in. on _____

(Date)

Water is controlled by _____

(Cap, valve, etc.)

8. **Casing:** (Give diameter, commercial specifications and depth below ground surface of each casing size.)

4 inch diameter Steel Well Casing from 0 to 27 feet
 inch diameter from to feet
 inch diameter from to feet
 inch diameter from to feet

Describe and show depth of shoe, plug, adapter, liner or other details:

9. Perforated Casings or Screens:

None from to
(Number per foot and size of perforations, or describe screen)

from to

from to


from to

from to

10. **Log of Well:** (Describe each stratum or formation clearly, indicate if water bearing, and give thickness and depth as indicated.)

[illegible]

Township 15S Range 2W, W.M.,
North

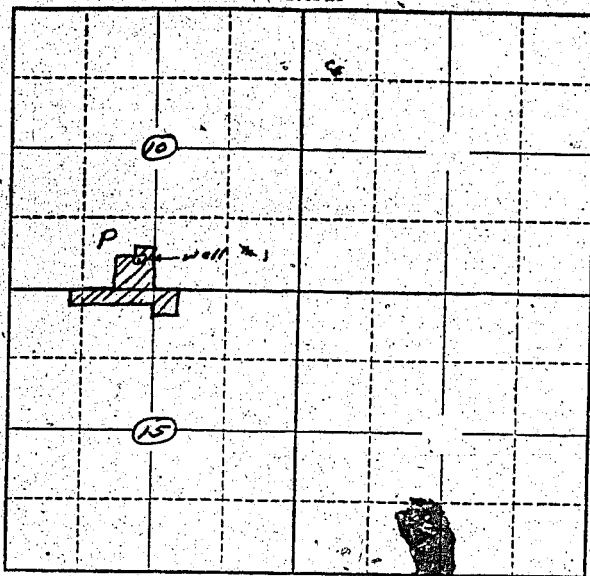

Locate well and acreage of irrigated land on plat.
Scale: 2" = 1 Mile.

STATE OF OREGON

County of Lane

ss.

I, Carrol Johnson, being first duly sworn, do hereby certify that I have read the foregoing Registration Statement and that all of the items therein contained are true to the best of my knowledge and belief.

Carrol Johnson
(Signature of Registrant)

Subscribed and sworn to before me this 14 day of March, 1950.

My commission expires June 25, 1961.

Ruth A. Jensen
(Notary Public)

(SEAL)

CERTIFICATE OF REGISTRATION

STATE OF OREGON

County of Marion

ss.

This is to certify that the foregoing Registration Statement was received in the office of the State Engineer on the 18th day of July, 1950 at 8:00 o'clock A. M. and has been duly recorded in said office in Book No. 10 of Registration Statements on page GR-221.

Witness my hand this 10th day of March, 1959

Lewis A. Stanley
(State Engineer)

By

(Deputy)

GR-221