

RECEIVED
JUL 21 1958
STATE ENGINEER
SALEM, OREGON

Registration No. GR- 2328

Certificate No. GR 2214

Registration Statement

OF CLAIMANT OF RIGHT TO APPROPRIATE GROUND WATER

TO THE STATE ENGINEER OF OREGON:

I, Francis A. D. Nible

of Route # 3 - Box 27 - Tillamook, Ore. County of Tillamook

State of Oregon, do hereby make application for a certificate of registration as evidence of a right to appropriate ground water.

1. Source from which water is withdrawn is Pump (A.C.)
(Flowing well, pump well, infiltration trench, or tunnel)

2. Location is: 3 mi. S.W. of Tillamook, Ore.
(Approximate distance and direction from nearest city or town)

and is more particularly described as follows:

(a) 2100 ft. West and 600 ft. North of the S.E. corner of S. 31. T. 36. R. 13. W. 2.
(Give distance and bearing to corner of section or other legal subdivision)

being within The S.W. 1/4 of the S.E. 1/4 of Sec. 36, Twp. 13, Rge. 13
(Smallest legal subdivision) (N. or S.) (E. or W.)

or (b) within limits of recorded platted property, town or city: (A.C.)

in Lot _____, Block _____ of _____
(Name of plat or addition)

County of _____
(If within city or town, give name)

3. Construction Work was begun on October 5, 1953; was completed on December 20, 1953
(Date) (Date)

and the ground water claimed was first used for the purposes set out below on May 1, 1954
(Date)

since which time the water has been used Intermittently
(Continuously or intermittently)

from May to November, each year
(Date) (Date)

4. Quantity of water claimed and used is _____ gallons per minute; _____ acre feet per year.

5. Purpose or Purposes for which water is used Irrigation

(Domestic, irrigation, municipal, manufacturing, industrial, etc.)

6. Description of Well: Depth 122 feet. Type Drilled
(Dug or drilled)

diameter 10 inches. Elevation of ground at well site 3 feet, mean sea level.
(As near as known)

Depth to water table 1 feet.

7. Capacity of Well: _____ g.p.m. with _____ feet drawdown.

_____ g.p.m. with _____ feet drawdown.


Date of test February 1, 1954

If Flowing Well: Measured discharge _____ g.p.m. on _____
(Date)

Shut-in pressure at ground surface _____ lbs. per sq. in. on _____
(Date)

Water is controlled by _____
(Cap, valve, etc.)

Township 15^{34N} Range 2S Range 10W, W.M.
North

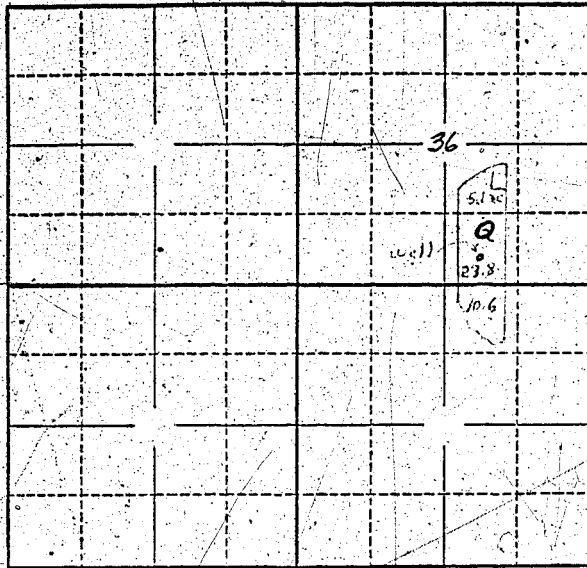

Locate well and acreage of irrigated land on plat.
Scale: 2" = 1 Mile

STATE OF OREGON

County of Tillamook } ss.

I, Lawrence M. De Noble, being first duly sworn, do hereby certify that I have read the foregoing Registration Statement and that all of the items therein contained are true to the best of my knowledge and belief.

Lawrence M. De Noble
(Signature of Registrant)

Subscribed and sworn to before me this 19 day of July, 1958.

My commission expires 9/10/58

Leatha Putman
(Notary Public)

(SEAL)

CERTIFICATE OF REGISTRATION

STATE OF OREGON

County of Marion } ss.

This is to certify that the foregoing Registration Statement was received in the office of the State Engineer on the 21 day of July, 1958, at 8:00 o'clock A. M. and has been duly recorded in said office in Book No. 10 of Registration Statements on page GR-2211

Witness my hand this 10th day of March, 1959

Lewis A. Stanley
(State Engineer)

By _____ (Deputy)

\$16.50

GR-2211