

Registration Statement

OF CLAIMANT OF RIGHT TO APPROPRIATE GROUND WATER

TO THE STATE ENGINEER OF OREGON:

I, Time Rictor

of Corvallis Rt. #3, Box 595 County of Benton

State of Oregon, do hereby make application for a certificate of registration as evidence of a right to appropriate ground water.

1. Source from which water is withdrawn is Pump Well
(Flowing well, pump well, infiltration trench, or tunnel)

2. Location is: 13 miles South of Corvallis
(Approximate distance and direction from nearest city or town)

and is more particularly described as follows:

(a) Well situated S 35°W -- 178.6' from 1/4 Cor. bet. Sec 2 and 3
(Give distance and bearing to corner of section or other legal subdivision)

being within NE 1/4 of S.E. 1/4 of Sec. 3, Twp. 14 S, Rge. 5W WM
(Smallest legal subdivision) (N. or S.) (E. or W.)

or (b) within limits of recorded platted property, town or city:

in Lot _____, Block _____ of _____
(Name of plat or addition)

County of _____
(If within city or town, give name)

3. Construction Work was begun on June 1951; was completed on June 1951
(Date) (Date)

and the ground water claimed was first used for the purposes set out below on June 1951
(Date)

since which time the water has been used intermittently
(Continuously or intermittently)

from 1951 to Present Time
(Date) (Date) (13 -- 8 gal. sprinklers)

4. Quantity of water claimed and used is 100 gallons per minute; 18 acre feet per year.

5. Purpose or Purposes for which water is used irrigation

(Domestic, irrigation, municipal, manufacturing, industrial, etc.)

6. Description of Well: Depth 31 feet. Type drilled
(Dug or drilled)

diameter 5 inches. Elevation of ground at well site 258' feet, mean sea level.
(As near as known)

Depth to water table 13 feet.

7. Capacity of Well: 100 g.p.m. with 1 feet drawdown.

_____ g.p.m. with _____ feet drawdown.

Date of test _____

If Flowing Well: Measured discharge _____ g.p.m. on _____
(Date)

Shut-in pressure at ground surface _____ lbs. per sq. in. on _____
(Date)

Water is controlled by _____
(Cap, valve, etc.)

8. **Casing:** (Give diameter, commercial specifications and depth below ground surface of each casing size.)

5 inch diameter entire 31' length from to feet
 inch diameter from to feet
 inch diameter from to feet
 inch diameter from to feet


Describe and show depth of shoe, plug, adapter, liner or other details:

20' length of 3" pipe with 3" Ft. valve

9. **Perforated Casings or Screens:**

Lower 5' notched with cutting torch from to
(Number per foot and size of perforations, or describe screen)

..... from to'

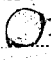..... from to' 

..... from to'

10. **Log of Well:** (Describe each stratum or formation clearly, indicate if water bearing, and give thickness and depth as indicated.)

MATERIAL	Thickness (Feet)	Depth to Bottom (Feet)
Chehallis soil	12"-15"	
Sandy loam	3 1/2' - 4'	
Coarse Sand and Gravel	26'	

If log of well is not available, give name and address of driller. Frank Skillings

Corvallis Rt. #1

11. Infiltration Trench: Covered or open
Dimensions: Length ft. Minimum depth ft. Maximum depth ft.
Bottom width ft. Discharge g.p.m. Date of test

12. Tunnel: Type of lining
Dimensions:
(Length, course, and cross sectional size)
Position of water bearing stratum with reference to portal of tunnel

Log of tunnel: (Preceding table for log of well may be used, if desired. Give footage from portal and character of materials, as pertinent.)


13. Pumping Equipment:
(a) Pump Fairbanks -- Morse Capacity 100 g.p.m.
(Make, type and size)
(b) Motor 5 H. P. Induction Motor
(Type and horsepower)

14. Location of area irrigated or to be irrigated, or place of use if for purposes other than irrigation.

Township North or South	Range E. or W. of Willamette Meridian	Section	Forty-acre Tract	Number Acres To Be Irrigated	Date of Reclamation
T14S	R 5 W	3	NE 1/4 SE 1/4	9	1951

15. If the ground water supply is supplemental to an existing water supply, identification of any application for a permit, permit, certificate or adjudicated right to appropriate water made or held by the registrant.

Township 14S Range 5W, W.M.
North

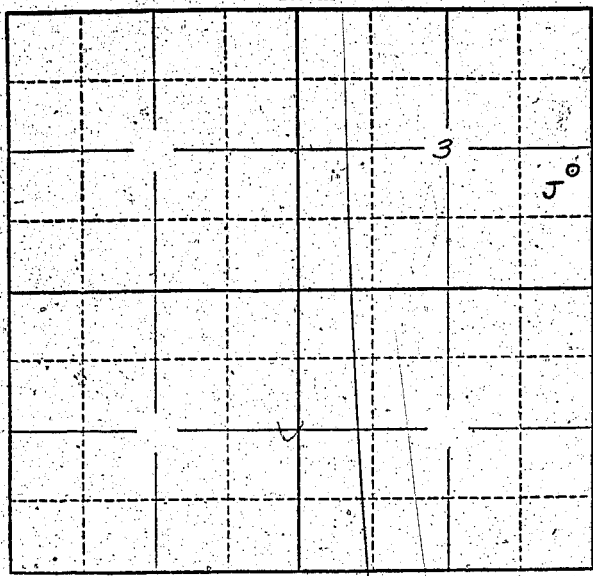

map attached

Locate well and acreage of irrigated land on plat.
Scale: 2" = 1 Mile

STATE OF OREGON }
County of Benton } ss.

I, TUNE RICTOR, being first duly sworn, do hereby certify that I have read the foregoing Registration Statement and that all of the items therein contained are true to the best of my knowledge and belief.

Tune Rictor
(Signature of Registrant)

Subscribed and sworn to before me this 18 day of July, 1958.

My commission expires C. W. CARTER
My Commission Expires Aug. 18, 1964 (Notary Public)

(SEAL)

CERTIFICATE OF REGISTRATION

STATE OF OREGON }
County of Marion } ss.

This is to certify that the foregoing Registration Statement was received in the office of the State Engineer on the 21 day of July, 1958, at 8:00 o'clock A. M. and has been duly recorded in said office in Book No. 10 of Registration Statements on page GR-2220

Witness my hand this 10th day of March, 1959

Lewis A. Stanley
(State Engineer)

\$1500.

By _____ (Deputy)

GR 2220