

RECEIVED
MAY 21 1950
STATE ENGINEER
SALEM, OREGON
RECEIVED

Registration No. GR - 2335
Certificate No. GR - 3901

Registration Statement

OF CLAIMANT OF RIGHT TO APPROPRIATE GROUND WATER

TO THE STATE ENGINEER OF OREGON:

I, H.H. Hebrke

of 1120 N. 2nd St., Corvallis County of Benton
(Mailing address)

State of Oregon, do hereby make application for a certificate of registration as evidence of a right to appropriate ground water.

1. Source from which water is withdrawn is Pump well
(Flowing well, pump well, infiltration trench, or tunnel)

2. Location is: in Corvallis, Oregon
(Approximate distance and direction from nearest city or town)

and is more particularly described as follows: 1205 feet S. 28° 38' E of the southwest corner

(a) of the John Stewart D.L.C. No. 49,
S.W. 4 (Give distance and bearing to corner of section or other legal subdivision)

being within 4 of NE 1 of Sec. 35, Twp. 11 S. Rge. 5 W.
(Smallest legal subdivision) (N. or S.) (E. or W.)

or (b) within limits of recorded platted property, town or city:

in Lot _____, Block _____ of _____
(Name of plat or addition)

(If within city or town, give name) County of _____

3. Construction Work was begun on May 14, 1944; was completed on May 2, 1944
(Date) (Date)

and the ground water claimed was first used for the purposes set out below on about May 10, 1944
(Date)

since which time the water has been used Regularly during irrigation season
(Continuously or intermittently)

from 1944 to 1958
(Date) (Date)

4. Quantity of water claimed and used is 20 gals gallons per minute; _____ acre feet per year.

5. Purpose or Purposes for which water is used Irrigation

(Domestic, irrigation, municipal, manufacturing, industrial, etc.)

6. Description of Well: Depth 42 feet. Type Drilled
(Dug or drilled)

diameter 4 inches. Elevation of ground at well site 110' feet, mean sea level.
(As near as known)

Depth to water table 16-20 feet.

7. Capacity of Well: Never Measured g.p.m. with _____ feet drawdown.
_____ g.p.m. with _____ feet drawdown.


Date of test _____

If Flowing Well: Measured discharge _____ g.p.m. on _____
(Date)

Shut-in pressure at ground surface _____ lbs. per sq. in. on _____
(Date)

Water is controlled by _____
(Cap. valve, etc.)

Township 11 S Range 5 W W.M.
North

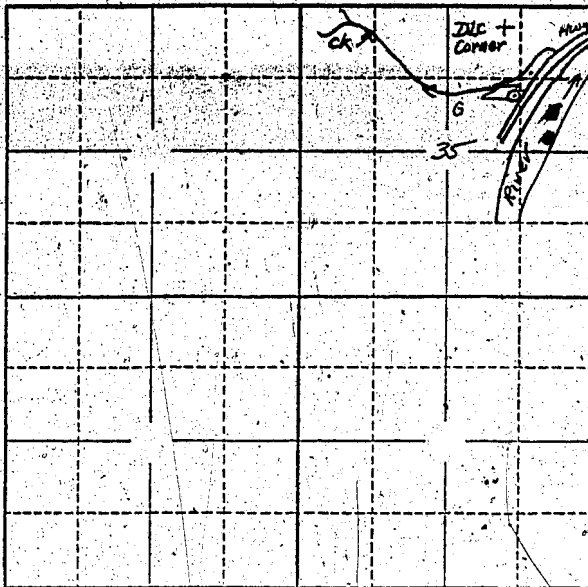

Locate well and acreage of irrigated land on plat.

Scale: 2" = 1 Mile

STATE OF OREGON

County of Benton } ss.

I, H. H. Hehrke, being first duly sworn, do hereby certify that I have read the foregoing Registration Statement and that all of the items therein contained are true to the best of my knowledge and belief.

H. H. Hehrke
(Signature of Registrant)

Subscribed and sworn to before me this 19 day of July, 1958

My commission expires My Commission Expires March 29, 1960

[Signature]
(Notary Public)

(SEAL)

CERTIFICATE OF REGISTRATION

STATE OF OREGON

County of Marion } ss.

This is to certify that the foregoing Registration Statement was received in the office of the State Engineer on the 21 day of July, 1958, at 8:00 o'clock A.M. and has been duly recorded in said office in Book No. 16 of Registration Statements on page GR3901

Witness my hand this 15th day of February, 1960

[Signature]
(State Engineer)

By _____
(Deputy)

GR 3901

1500