

# Registration Statement

## OF CLAIMANT OF RIGHT TO APPROPRIATE GROUND WATER

TO THE STATE ENGINEER OF OREGON:

I, E. S. O. C. WEIDMAN  
of Rt. 2, Box 310, Molalla County of CLACKAMAS  
(Mailing address)

State of OREGON, do hereby make application for a certificate of registration as evidence of a right to appropriate ground water.

1. Source from which water is withdrawn is Dump Well  
(Flowing well, pump well, infiltration trench, or tunnel)

2. Location is: 1 1/2 Miles E. of Molalla  
(Approximate distance and direction from nearest city or town)

and is more particularly described as follows:

(a) S 20° W, 1675' FROM NE CORNER SEC. 15  
(Give distance and bearing to corner of section or other legal subdivision)

being within SE 1/4 NE 1/4 of Sec. 15, Twp. 5S Rge. 2E  
(Smallest legal subdivision) (N. or S.) (E. or W.)

or (b) within limits of recorded platted property, town or city:

in Lot \_\_\_\_\_, Block \_\_\_\_\_ of \_\_\_\_\_  
(Name of plat or addition)

County of \_\_\_\_\_  
(If within city or town, give name)

3. Construction Work was begun on JULY 1953; was completed on SEPT. 1953  
(Date) (Date)

and the ground water claimed was first used for the purposes set out below on SEPT. 1953  
(Date)

since which time the water has been used INTERMITTENTLY  
(Continuously or Intermittently)

from SEPT 1953 to OCT. 1957  
(Date) (Date)

4. Quantity of water claimed and used is 35 gallons per minute; ? acre feet per year.

5. Purpose or Purposes for which water is used IRRIGATION  
(Domestic, irrigation, municipal, manufacturing, industrial, etc.)

6. Description of Well: Depth 9' feet. Type DUG  
(Dug or drilled)

diameter 5' x 5' inches. Elevation of ground at well site 115' feet, mean sea level.  
(As near as known)

Depth to water table 2 1/2 feet.

7. Capacity of Well: 80 g.p.m. with 6 1/2 feet drawdown.

\_\_\_\_\_ g.p.m. with \_\_\_\_\_ feet drawdown.

Date of test SEPT 1953

If Flowing Well: Measured discharge \_\_\_\_\_ g.p.m. on \_\_\_\_\_  
(Date)

Shut-in pressure at ground surface \_\_\_\_\_ lbs. per sq. in. on \_\_\_\_\_  
(Date)

Water is controlled by \_\_\_\_\_  
(Cap, valve, etc.)

8. Casing: (Give diameter, commercial specifications and depth below ground surface of each casing size.)

inch diameter 5' X 5' LUMBER 6 1/2' LONG from ..... to ..... feet  
inch diameter ..... from ..... to ..... feet  
inch diameter ..... from ..... to ..... feet  
inch diameter ..... from ..... to ..... feet

Describe and show depth of shoe, plug, adapter, liner or other details:  
.....  
.....  
.....

9. Perforated Casings or Screens:

NONE from ..... to .....  
(Number per foot and size of perforations, or describe screen.)  
from ..... to .....  
from ..... to .....  
from ..... to .....

10. Log of Well: (Describe each stratum or formation clearly, indicate if water bearing, and give thickness and depth as indicated.)

MATERIAL	Thickness (Feet)	Depth to Bottom (Feet)
DIRT WITH SMALL AMOUNT OF WATER	4'	
HARD PACKED GRAVEL	1 1/2'	
LOOSE GRAVEL AND BOULDERS	3 1/2'	

If log of well is not available, give name and address of driller. ....

11. Infiltration Trench: Covered or open .....

Dimensions: Length ..... ft. Minimum depth ..... ft. Maximum depth ..... ft.

Bottom width ..... ft. Discharge ..... g.p.m. Date of test .....

12. Tunnel: Type of lining .....

Dimensions: .....  
(Length, course, and cross sectional size)

Position of water bearing stratum with reference to portal of tunnel .....

Log of tunnel: (Preceding table for log of well may be used, if desired. Give footage from portal and character of materials, as pertinent.)

13. Pumping Equipment: UNITYPE

(a) Pump PACIFIC CENTRIFUGAL 1 1/4" Capacity 2 g.p.m.  
(Make, type and size)


(b) Motor G.E. 2 H.P. CAPACITOR 1 PHASE 3000 RPM  
(Type and horsepower)

14. Location of area irrigated or to be irrigated, or place of use if for purposes other than irrigation.

Township North or South	Range E or W. of Willamette Meridian	Section	Forty-acre Tract	Number Acres To Be Irrigated	Date of Reclamation
5S	2E	15	SE 1/4 NE 1/4	6.9	1953

15. If the ground water supply is supplemental to an existing water supply, identification of any application for a permit, permit, certificate or adjudicated right to appropriate water made or held by the registrant.

Township 55 Range 2E, W.M.  
North

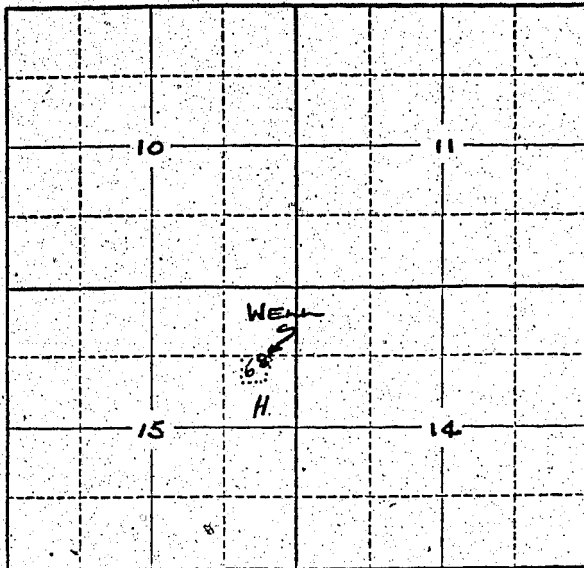

Locate well and acreage of irrigated land on plat.  
Scale: 2" = 1 Mile

STATE OF OREGON

County of CLACKAMAS

} ss.

I, EDWIN WEIDMAN, being first duly sworn, do hereby certify that I have read the foregoing Registration Statement and that all of the items therein contained are true to the best of my knowledge and belief.

Edwin Weidman  
(Signature of Registrant)

Subscribed and sworn to before me this 21st day of July, 1958.

My commission expires 11-11-59

(Notary Public)

(SEAL)

**CERTIFICATE OF REGISTRATION**

STATE OF OREGON

County of Marion

} ss.

This is to certify that the foregoing Registration Statement was received in the office of the State Engineer on the 21 day of July, 1958, at 8:00 o'clock A. M. and has been duly recorded in said office in Book No. 10 of Registration Statements on page GR-2221

Witness my hand this 10th day of March, 1959.

Lewis A. Stanley  
(State Engineer)

By

(Deputy)

\$1500

GR - 2221