

RECEIVED

AUG 15 1956

STATE ENGINEER
SALEM, OREGON

Registration Statement

REGISTRATION NO. GR-234

CERTIFICATE NO. GR-213

OF CLAIMANT OF RIGHT TO APPROPRIATE GROUND WATER

(Under Chapter 708, Oregon Laws 1955.)

TO THE STATE ENGINEER OF OREGON:

I, Emery Alderman
of Salem County of MarionState of Oregon, do hereby make application for a certificate of registration as evidence of a right to appropriate ground water.1. Source from which water is withdrawn is pump well
(Flowing well, pump well, infiltration trench, or tunnel)2. Location is: at 4490 Silverton Road Salem Oregon
(Approximate distance and direction from nearest city or town)

and is more particularly described as follows:

(a) 709' S. and 161' W. at the Most E 1/4 NE corner Sec 18
(Give distance and bearing to corner of section or other legal subdivision)
being within NW 1/4 NE 1/4 of Sec. 18, Twp. 7 South Rge. 2 West.
(Smallest legal subdivision) (N. or S.) (E. or W.)

or (b) within limits of recorded platted property, town or city:

in Lot 13, Block - of Hollywood Subdivision
(Name of plat or addition)

(If within city or town, give name)

County of Marion3. Construction Work was begun on June 1955; was completed on July 11-1955
(Date) (Date)and the ground water claimed was first used for the purposes set out below on July 12-1955
(Date)since which time the water has been used intermittently continuously
(Continuously or intermittently)from July 12-1955 to _____
(Date) (Date)4. Quantity of water claimed and used is 60 gallons per minute; _____ acre
feet per year.5. Purpose or Purposes for which water is used irrigation

(Domestic, irrigation, municipal, manufacturing, industrial, etc.)

6. Description of Well: Depth 117 feet. Type drilled
(Dug or drilled)diameter 8 inches. Elevation of ground at well site 185 feet, mean sea level.
(As near as known)Depth to water table 22 feet.7. Capacity of Well: 68 g.p.m. with 36 feet drawdown.302 g.p.m. with 77 feet drawdown.Date of test 7/11/55If Flowing Well: Measured discharge _____ g.p.m. on _____
(Date)Shut-in pressure at ground surface _____ lbs. per sq. in. on _____
(Date)Water is controlled by _____
(Cap, valve, etc.)

size.

8

inch diameter

inch diameter

inch diameter

Describe and show depth of shoe, plug, adapter, liner or other details:

55

(Number per foot and size of perforations, or describe screen)

from

from

from

10. Log of Well: (Des.)

MATERIAL

Thickness
(Feet)

Depth to Bottom
(Feet)

Emil Beier
Salem, Oregon

Rt. 2

Salem, Oregon

Dimensions: Length ft. Minimum depth ft. Maximum depth ft.

Bottom width ft. Discharge g.p.m. Date of test

Dimensions: _____

Position of water bearing stratum with reference to portal of tunnel _____

13. Pumping Equipment:

(a) Pump Berkley Capacity 60 g.p.m.


(b) Motor GE 5 HP Jet
(Type and horsepower)

14. Location of area irrigated or to be irrigated, or place of use if for purposes other than irrigation.

[illegible]

15. If the ground water supply is supplemental to an existing water supply, identification of any application for a permit, permit, certificate or adjudicated right to appropriate water made or held by the registrant.

Township 7S Range 2W W.M.
North

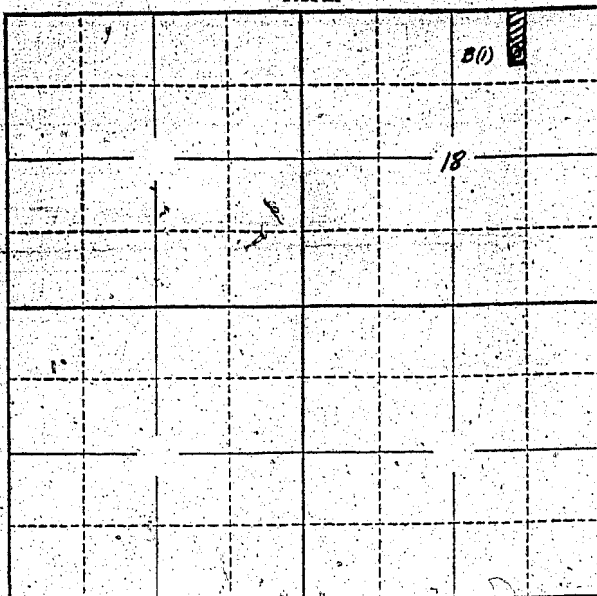

Locate well and acreage of irrigated land on plat.

Scale: 2" = 1 Mile

STATE OF OREGON

County of Marion

ss.

I, Emery Alderman, being first duly sworn, do hereby certify that I have read the foregoing Registration Statement and that all of the items therein contained are true to the best of my knowledge and belief.

Emery Alderman
(Signature of Registrant)

Subscribed and sworn to before me this 15th day of August, 1956

My commission expires Sept. 8, 1956

Chas. E. Wilson
(Notary Public)

(SEAL)

CERTIFICATE OF REGISTRATION

STATE OF OREGON

County of Marion

ss.

This is to certify that the foregoing Registration Statement was received in the office of the State Engineer on the 15th day of August, 1956, at 10 o'clock A.M. and has been duly recorded in said office in Book No. 2 of Registration Statements on page GR-213 C

~~Construction shall be completed by X-X-X-X-X-X-X-X-X-X and the water completely applied to beneficial use by X-X-X-X-X-X-X-X-X-X~~

Witness my hand this 23rd day of November, 1956

Lewis A. Stanley
(State Engineer)

By

(Deputy)

GR-213 C