

Registration Statement

REGISTRATION NO. OR-2340CERTIFICATE NO. GR-2201

OF CLAIMANT OF RIGHT TO APPROPRIATE GROUND WATER

(Under Chapter 708, Oregon Laws 1955.)

TO THE STATE ENGINEER OF OREGON:

I, C. C. Snyderof 1100 N.W. 317th Av, Hillsboro County of WashingtonState of Oregon do hereby make application for a certificate of registration as evidence of a right to appropriate ground water.

1. Source from which water is withdrawn is Pump well
(Flowing well, pump well, infiltration trench, or tunnel)
2. Location is: Adjoins west boundary of Hillsboro on Garzboldi st.
(Approximate distance and direction from nearest city or town)

and is more particularly described as follows:

- (a)
- 2200 feet east of 2400 feet south from NW corner Section 36
-
- (Give distance and bearing to corner of section or other legal subdivision)

being within Hillsboro Garden Tract of Sec. 36, Twp. 1N, Rge. 3W
(Smallest legal subdivision) (N. or S.) (E. or W.)

or (b) within limits of recorded platted property, town or city:

in Lot 2 and 3, Block 6 of Hillsboro Garden Tract.
(Name of plat or addition)Adjoining Hillsboro County of Washington
(If within city or town, give name)

3. Construction Work was begun on
- Aug 1946
- ; was completed on
- Aug 1946
-
- (Date) (Date)

and the ground water claimed was first used for the purposes set out below on Aug 1946
(Date)since which time the water has been used Continuously
(Continuously or Intermittently)from 1946 to 1958
(Date) (Date)

4. Quantity of water claimed and used is
- 15
- gallons per minute;
- 5
- acre feet per year.

5. Purpose or Purposes for which water is used
- irrigation

(Domestic, irrigation, municipal, manufacturing, industrial, etc.)


6. Description of Well: Depth
- 45
- feet. Type
- Dug to 23' drilled to 45'
-
- (Dug or drilled)
-
- diameter
- drilled part 4 1/2"
- inches. Elevation of ground at well site
- 168
- feet, mean sea level.
-
- (As near as known)

Depth to water table 20 feet.

7. Capacity of Well:
- 15
- g.p.m. with
- ?
- feet drawdown.
-
- g.p.m. with
- ?
- feet drawdown.

Date of test noneIf Flowing Well: Measured discharge X g.p.m. on X
(Date)Shut-in pressure at ground surface X lbs. per sq. in. on X
(Date)Water is controlled by X
(Cap, valve, etc.)

Township 1N Range 1W, W.M.
North

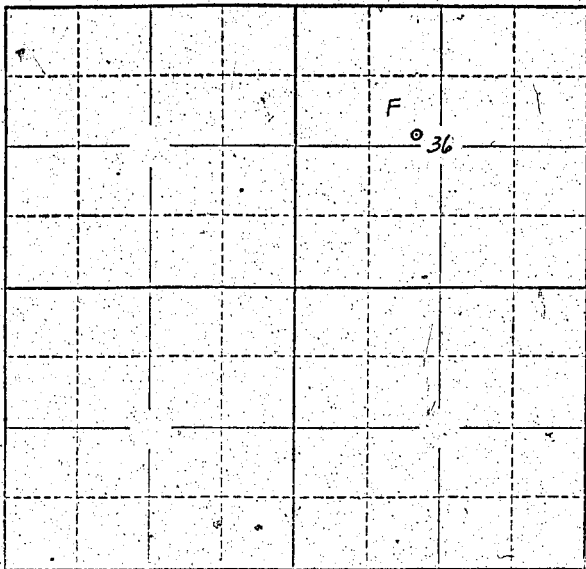

Locate well and acreage of irrigated land on plat.
Scale: 2" = 1 Mile

STATE OF OREGON

County of Marion } ss.

I, Chrysler, being first duly sworn, do hereby certify that I have read the foregoing Registration Statement and that all of the items therein contained are true to the best of my knowledge and belief.

Chrysler

(Signature of Registrant)

Subscribed and sworn to before me this 7th day of July, 1958

My commission expires 12th June 1961 Wm. S. Beathornes
(Notary Public)

(SEAL)

CERTIFICATE OF REGISTRATION

STATE OF OREGON

County of Marion } ss.

This is to certify that the foregoing Registration Statement was received in the office of the State Engineer on the 21 day of July, 1958 at 8:00 o'clock A.M. and has been duly recorded in said office in Book No. 10 of Registration Statements on page GR-2221

~~Construction shall be completed by 10 o'clock on or before 10/15/58~~
~~no further work to be done after 10/15/58~~

Witness my hand this 10th day of March, 1959

Henry A. Blumley
(State Engineer)

\$15.00

By _____ (Deputy)

GR-2221