

Registration No. GR - 2341

Certificate No. GR - 2225

Registration Statement

OF CLAIMANT OF RIGHT TO APPROPRIATE GROUND WATER

TO THE STATE ENGINEER OF OREGON:

I, C. D. BRYAN
of RR 2, Box 244A, Eugene, OR County of DEWEE
(Mailing address)

State of OREGON, do hereby make application for a certificate of registration as evidence of a right to appropriate ground water.

1. Source from which water is withdrawn is PUMP WELL #2
(Flowing well, pump well, infiltration trench, or tunnel)

2. Location is: 1/8 mi S from Caburg
(Approximate distance and direction from nearest city or town)

and is more particularly described as follows:

(a) N 64° 0' E 1790' from SW. Cor. Jonathan Thomas P.L.C. #60
(Give distance and bearing to corner of section or other legal subdivision)

being within NW/5W of Sec. 33, Twp. 16 S, Rge. 3W
(Smallest legal subdivision) (N. or S.) (E. or W.)

or (b) within limits of recorded platted property, town or city:

in Lot, _____, Block _____ of _____
(Name of plat or addition)

County of DEWEE
(If within city or town, give name)

3. Construction Work was begun on 1933; was completed on 1933
(Date) (Date)

and the ground water claimed was first used for the purposes set out below on 1933
(Date)

since which time the water has been used Continuously
(Continuously or intermittently)

from 11/15/33 to Sept 15
(Date) (Date)

4. Quantity of water claimed and used is 240 gallons per minute; _____ acre feet per year.

5. Purpose or Purposes for which water is used Irrigation
(Domestic, irrigation, municipal, manufacturing, industrial, etc.)

6. Description of Well: Depth 16 feet. Type Dug or drilled
diameter 4.2 inches. Elevation of ground at well site 416 feet, mean sea level.
(As near as known)

Depth to water table 8 feet.

7. Capacity of Well: 240 g.p.m. with 3 feet drawdown.
_____ g.p.m. with _____ feet drawdown.

Date of test _____

If Flowing Well: Measured discharge _____ g.p.m. on _____
(Date)

Shut-in pressure at ground surface _____ lbs. per sq. in. on _____
(Date)

Water is controlled by _____
(Cap, valve, etc.)

8. Casing: (Give diameter, commercial specifications and depth below ground surface of each casing size.)

42 inch diameter wood from 0 to 16 feet
inch diameter from to feet
inch diameter from to feet
inch diameter from to feet

Describe and show depth of shoe, plug, adapter, liner or other details:

9. Perforated Casings or Screens:

from to
(Number per foot and size of perforations, or describe screen)
from to
from to
from to

10. Log of Well: (Describe each stratum or formation clearly, indicate if water bearing, and give thickness and depth as indicated.)

MATERIAL	Thickness (Feet)	Depth to Bottom (Feet)
Sand and gravel and boulders		

If log of well is not available, give name and address of driller. *By owner*

11. Infiltration Trench: Covered or open

Dimensions: Length ft. Minimum depth ft. Maximum depth ft.

Bottom width ft. Discharge g.p.m. Date of test

12. Tunnel: Type of lining

Dimensions:
(Length, course, and cross sectional size)

Position of water bearing stratum with reference to portal of tunnel

Log of tunnel: (Preceding table for log of well may be used, if desired. Give footage from portal and character of materials, as pertinent.)

13. Pumping Equipment:

(a) Pump *Cent. 2 1/2" Allen Chalmers* Capacity *240* g.p.m.
(Make, type and size)


(b) Motor *15 HP*
(Type and horsepower)

14. Location of area irrigated or to be irrigated, or place of use if for purposes other than irrigation.

Township North or South	Range E. or W. of Willamette Meridian	Section	Forty-acre Tract	Number Acres To Be Irrigated	Date of Reclamation
T16S	3W	32	NE 1/4 SE 1/4	5 ac	1935
"	"	"	SE 1/4 SE 1/4	5 ac	"
"	"	33	NW 1/4 SW 1/4	11.8 ac	"
"	"	"	SW 1/4 SW 1/4	12.0	"
				Total 33.8	

15. If the ground water supply is supplemental to an existing water supply, identification of any application for a permit, permit, certificate or adjudicated right to appropriate water made or held by the registrant.

Township 16 S Range 3 W, W.M.
North

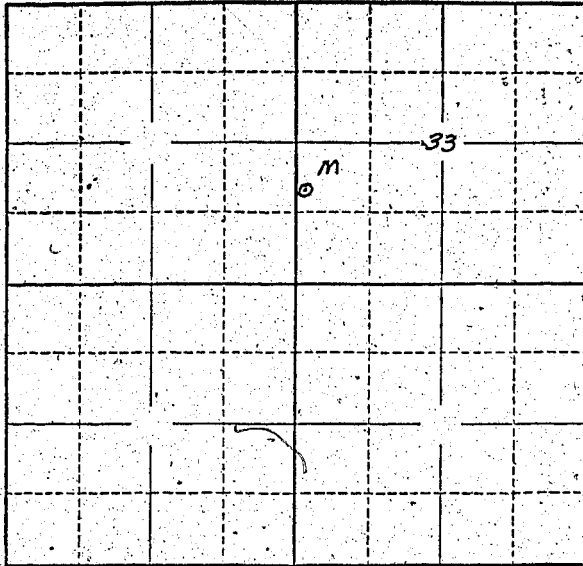

Locate well and acreage of irrigated land on plat.
Scale: 2" = 1 Mile

STATE OF OREGON

County of Lane } ss.

I, C. W. Peterson, being first duly sworn, do hereby certify that I have read the foregoing Registration Statement and that all of the items therein contained are true to the best of my knowledge and belief.

C. W. Peterson
(Signature of Registrant)

Subscribed and sworn to before me this 19th day of July, 1958

My commission expires 6/10/62 Elyse B. Johnson
(Notary Public)

(SEAL)

CERTIFICATE OF REGISTRATION

STATE OF OREGON

County of Marion } ss.

This is to certify that the foregoing Registration Statement was received in the office of the State Engineer on the 21 day of July, 1958, at 8:00 o'clock A. M. and has been duly recorded in said office in Book No. 10 of Registration Statements on page GR-2225

Witness my hand this 10th day of March, 1959

Laura A. Stanley
(State Engineer)

By _____
(Deputy)

#1560

GR-2225