

Registration Statement

OF CLAIMANT OF RIGHT TO APPROPRIATE GROUND WATER

TO THE STATE ENGINEER OF OREGON:

I, C. W. FARR
 of Rt. 2 Box 344A Eugene County of Lane
(Mailing address)
 State of OREGON, do hereby make application for a certificate of registration as evidence
 of a right to appropriate ground water.

1. Source from which water is withdrawn is PUMP WELL #1
(Flowing well, pump well, infiltration trench, or tunnel)

2. Location is: 1/2 mi. S from Coburg
(Approximate distance and direction from nearest city or town)

and is more particularly described as follows:

(a) N 51° E 1900' from SW COR Jonathan Thomas P.L.C. #60
(Give distance and bearing to corner of section or other legal subdivision)

being within NE/SE of Sec. 32, Twp. 16S, Rge. 3W
(Smallest legal subdivision) (N. or S.) (E. or W.)

or (b) within limits of recorded platted property, town or city:

in Lot _____, Block _____ of _____
(Name of plat or addition)
 County of Lane
(If within city or town, give name)

3. Construction Work was begun on 1935; was completed on 1935
(Date) (Date)

and the ground water claimed was first used for the purposes set out below on 1935
(Date)

since which time the water has been used _____
(Continuously or intermittently)

from May 1 to Sept. 15
(Date) (Date)

4. Quantity of water claimed and used is 240 gallons per minute; _____ acre
 feet per year.

5. Purpose or Purposes for which water is used: Irrigation

(Domestic, irrigation, municipal, manufacturing, industrial, etc.)

6. Description of Well: Depth 16 feet. Type Borehole Dug
(Dug or drilled)

diameter 2" inches. Elevation of ground at well site 416 feet, mean sea level.
(As near as known)

Depth to water table 8 feet.

7. Capacity of Well: _____ g.p.m. with _____ feet drawdown.

_____ g.p.m. with _____ feet drawdown.

Date of test _____

If Flowing Well: Measured discharge _____ g.p.m. on _____
(Date)

Shut-in pressure at ground surface _____ lbs. per sq. in. on _____
(Date)

Water is controlled by _____
(Cap, valve, etc.)

8. Casing: (Give diameter, commercial specifications and depth below ground surface of each casing size.)

..... inch diameter from to feet

..... inch diameter from to feet

..... inch diameter from to feet

..... inch diameter from to feet

Describe and show depth of shoe, plug, adapter, liner or other details:

.....

.....

9. Perforated Casings or Screens:

..... from to

(Number per foot and size of perforations, or describe screen)

..... from to

..... from to

..... from to

..... from to

10. Log of Well: (Describe each stratum or formation clearly, indicate if water bearing, and give thickness and depth as indicated.)

MATERIAL	Thickness (Feet)	Depth to Bottom (Feet)

If log of well is not available, give name and address of driller: Dug by owner

11. Infiltration Trench: Covered or open

Dimensions: Length ft. Minimum depth ft. Maximum depth ft.

Bottom width ft. Discharge g.p.m. Date of test

12. Tunnel: Type of lining

Dimensions:
(Length, course, and cross sectional size)

Position of water bearing stratum with reference to portal of tunnel

Log of tunnel: (Preceding table for log of well may be used, if desired. Give footage from portal and character of materials, as pertinent.)

13. Pumping Equipment:

(a) Pump Allis Chalmers Centrifugal 3" x 2 1/2" Capacity 300 g.p.m.
(Make, type and size)


(b) Motor Electric 15 HP
(Type and horsepower)

14. Location of area irrigated or to be irrigated, or place of use if for purposes other than irrigation.

Township North or South	Range East or West of Willamette Meridian	Section	Forty-acre Tract	Number Acres To Be Irrigated	Date of Reclamation
165	3W	32	NE/SE	5.0	1935
"	"	"	SE/SE	5.0	"
"	"	33	NW/SE	11.8	"
"	"	"	SW/SE	12.0	"
				33.8	

15. If the ground water supply is supplemental to an existing water supply, identification of any application for a permit, permit, certificate or adjudicated right to appropriate water made or held by the registrant.

Township 16S Range 3W W.M.
North

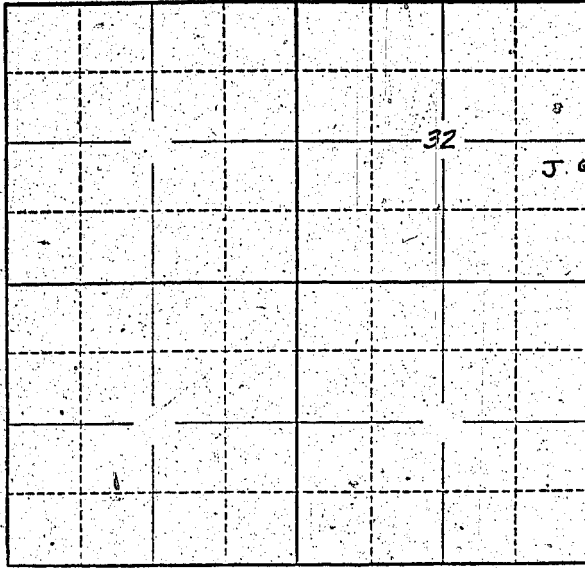

Locate well and acreage of irrigated land on plat.
Scale: 2" = 1 Mile

STATE OF OREGON

County of Lane } ss.

I, C. W. Pitkin, being first duly sworn, do hereby certify that I have read the foregoing Registration Statement and that all of the items therein contained are true to the best of my knowledge and belief.

C. W. Pitkin
(Signature of Registrant)

Subscribed and sworn to before me this 19th day of July, 1958

My commission expires 6/30/62 Elizabeth B. Kallala
(Notary Public)

(SEAL)

CERTIFICATE OF REGISTRATION

STATE OF OREGON

County of Marion } ss.

This is to certify that the foregoing Registration Statement was received in the office of the State Engineer on the 21 day of July, 1958, at 8:00 o'clock A. M. and has been duly recorded in said office in Book No. 10 of Registration Statements on page GR 2226

Witness my hand this 10th day of March, 1959

Lewis A. Stanley
(State Engineer)

By _____
(Deputy)

1/5/60