

Registration Statement

OF CLAIMANT OF RIGHT TO APPROPRIATE GROUND WATER

TO THE STATE ENGINEER OF OREGON:

I, La Rue Morris

of R.R.#1 Box 424 Central Point County of Jackson
(Mailing address)

State of Oregon, do hereby make application for a certificate of registration as evidence of a right to appropriate ground water.

1. Source from which water is withdrawn is Infiltration trench
(Flowing well, pump well, infiltration trench, or tunnel)

2. Location is: 5 miles from Central Point, Oregon;
(Approximate distance and direction from nearest city or town)

and is more particularly described as follows:

(a) 2706 ft. N. and 2541.5 ft. W. SE corner of Sec. 30
(Give distance and bearing to corner of section or other legal subdivision)

being within SW 1/4 NE 1 of Sec. 30, Twp. 36S, Rge. 2W
(Smallest legal subdivision) (N. or S.) (E. or W.)

or (b) within limits of recorded platted property, town or city:

in Lot _____, Block _____ of _____
(Name of plat or addition)

County of _____
(If within city or town, give name)

3. Construction Work was begun on Dec. 1946; was completed on March 1947
(Date) (Date)

and the ground water claimed was first used for the purposes set out below on April 1947,
(Date)

since which time the water has been used Continuously during irrigation seasons
(Continuously or intermittently)

from April 1947 to 1958
(Date) (Date)

4. Quantity of water claimed and used is 167 gallons per minute; 50 acre feet per year.

5. Purpose or Purposes for which water is used Irrigation and Supplemental

Irrigation
(Domestic, irrigation, municipal, manufacturing, industrial, etc.)

6. Description of Well: Depth _____ feet. Type _____
(Dug or drilled)

diameter _____ inches. Elevation of ground at well site _____ feet, mean sea level.
(As near as known)

Depth to water table _____ feet.

7. Capacity of Well: _____ g.p.m. with _____ feet drawdown.

_____ g.p.m. with _____ feet drawdown.


Date of test _____

If Flowing Well: Measured discharge _____ g.p.m. on _____
(Date)

Shut-in pressure at ground surface _____ lbs. per sq. in. on _____
(Date)

Water is controlled by _____
(Cap, valve, etc.)

Township 76 S. Range 2 W., W.M.
North

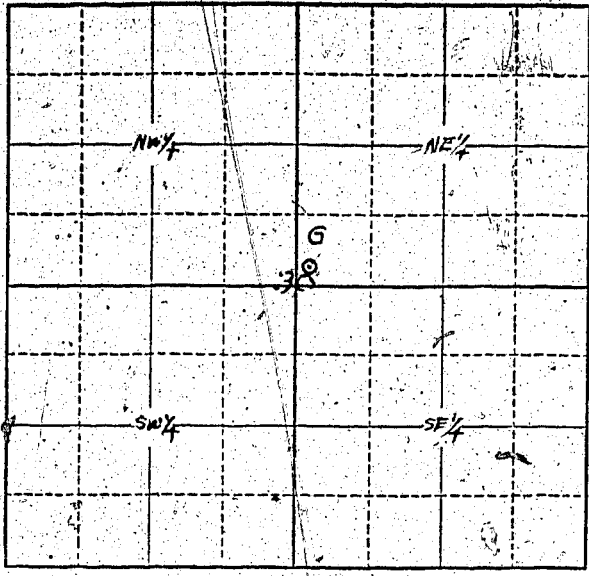

Locate well and acreage of irrigated land on plat.
Scale: 1/4 - 1 Mile

STATE OF OREGON }
County of Jackson } ss.

I, Ha Rue Morris, being first duly sworn, do hereby certify that I have read the foregoing Registration Statement and that all of the items therein contained are true to the best of my knowledge and belief.

Ha Rue Morris
(Signature of Registrant)

Subscribed and sworn to before me this 18th day of July, 1958

My commission expires Nov. 23-1960

Myrtle K. Lewis
(Notary Public) for Oregon

(SEAL)

CERTIFICATE OF REGISTRATION

STATE OF OREGON }
County of Marion } ss.

This is to certify that the foregoing Registration Statement was received in the office of the State Engineer on the 21st day of July, 1958, at 2:00 o'clock A. M. and has been duly recorded in said office in Book No. 10 of Registration Statements on page GR-2231

Witness my hand this 10th day of March, 1959

Lewis A. Stanley
(State Engineer)

\$15.00

By _____ (Deputy)

GR-2231