

RECEIVED
JUL 21 1936
STATE ENGINEER
SALEM, OREGON

Registration No. GR. 2350
Certificate No. GR. 2337

Registration Statement

OF CLAIMANT OF RIGHT TO APPROPRIATE GROUND WATER

TO THE STATE ENGINEER OF OREGON:

I, MELVIN SHORT
of 257 W 17TH STREET, EUGENE County of LANE
State of OREGON, do hereby make application for a certificate of registration as evidence
of a right to appropriate ground water.

1. Source from which water is withdrawn is PUMP WELL
(Flowing well, pump well, infiltration trench, or tunnel)
2. Location is: 6 MILES SOUTH OF JUNCTION CITY
(Approximate distance and direction from nearest city or town)

and is more particularly described as follows:

(a) 990 feet south & 1200 feet west from E 1/4 corner Section 27
(Give distance and bearing to corner of section or other legal subdivision)
being within Lot 4 NE 1/4 of SE 1/4 VITUS TRACT of Sec. 27, Twp. 16 S, Rge. 4 W
(Smallest legal subdivision) (N. or S.) (E. or W.)

or (b) within limits of recorded platted property, town or city:
in Lot 4, Block _____ of VITUS TRACT
(Name of plat or addition)
County of _____
(If within city or town, give name)

3. Construction Work was begun on JUNE 1936; was completed on JUNE 1936
(Date) (Date)
and the ground water claimed was first used for the purposes set out below on JUNE 1936
(Date)
since which time the water has been used INTERMITTENTLY
(Continuously or intermittently)
from JUNE 1936 to JUNE 1958
(Date) (Date)

4. Quantity of water claimed and used is 100 gallons per minute; _____ acre
feet per year.

5. Purpose or Purposes for which water is used: IRRIGATION
(Domestic, irrigation, municipal, manufacturing, industrial, etc.)

6. Description of Well: Depth 22 feet. Type DRIVEN
(Dug or drilled)
diameter 4 inches. Elevation of ground at well site 375 feet, mean sea level.
(As near as known)
Depth to water table 8 feet.

7. Capacity of Well: 100 g.p.m. with 0 feet drawdown.
_____ g.p.m. with _____ feet drawdown.


Date of test _____

If Flowing Well: Measured discharge _____ g.p.m. on _____
(Date)

Shut-in pressure at ground surface _____ lbs. per sq. in. on _____
(Date)

Water is controlled by _____
(Cap, valve, etc.)

Township 27S Range 4W, W.M.
North

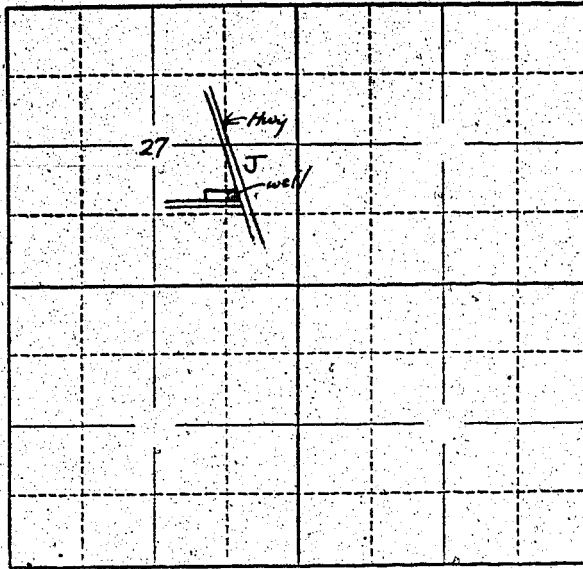

Locate well and acreage of irrigated land on plat.
Scale: 2" = 1 Mile

STATE OF OREGON

County of LANE } ss.

I, MELVIN SHORT, being first duly sworn, do hereby certify that I have read the foregoing Registration Statement and that all of the items therein contained are true to the best of my knowledge and belief.

Melvin Short
(Signature of Registrant)

Subscribed and sworn to before me this 19TH day of July, 1958

My commission expires July 11, 1961

[Signature]
(Notary Public)

(SEAL)

CERTIFICATE OF REGISTRATION

STATE OF OREGON } ss.
County of Marion

This is to certify that the foregoing Registration Statement was received in the office of the State Engineer on the 21st day of July, 1958, at 2:00 o'clock A.M. and has been duly recorded in said office in Book No. 10 of Registration Statements on page GR-223

Witness my hand this 10th day of March, 1959

Lewis A. Stanley
(State Engineer)

\$1500

By _____ (Deputy)